

Name

Service No.

Address 475 Concord Ave.

Lot A

Location

Kind of Pipe

Size

Size of Main

Repair—Renewal—New Service


Location

Date	Material	Amount	Total	Date	Amount
1971	21.1 6" transite pipe @	12.00	253.20		
				1971	
				20.6" Transite	

DATE 9/6/95

TOWN OF LEXINGTON — BOARD OF PUBLIC WORKS
SEWER DIVISION

Sketch of Service Here

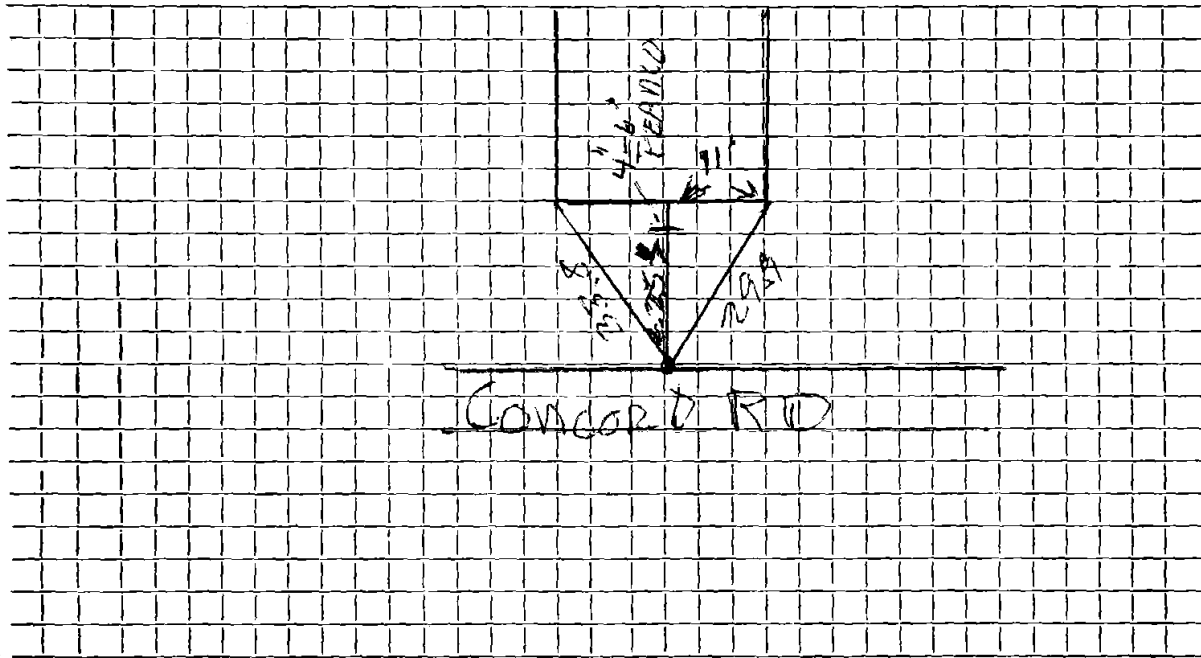

Connection made in 4.75 Concord Rd Street.

Work completed

Remarks:
.....
.....

DATE _____


TOWN OF LEXINGTON — BOARD OF PUBLIC WORKS

SEWER DIVISION

Sketch of Service Here

475

Lot A

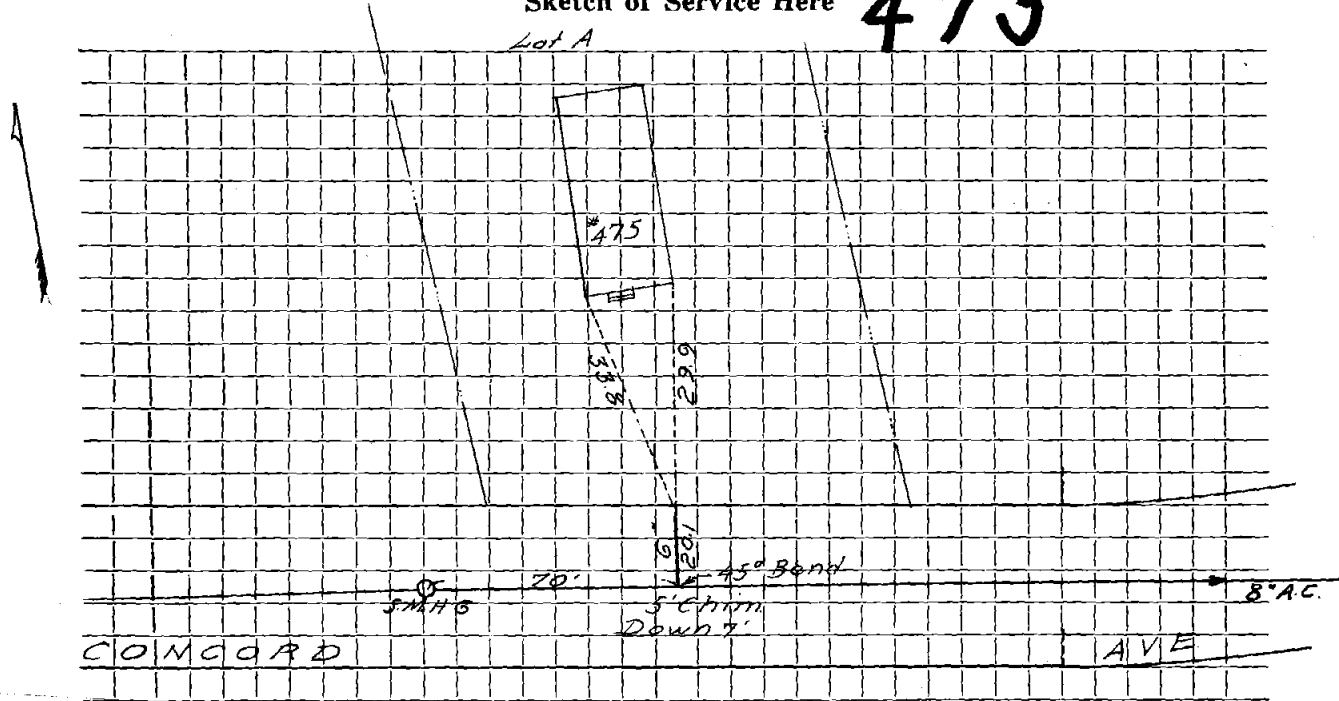

Connection made in Street. Work completed

Remarks: House is Connected

.....
.....