


DATE 10-1-01

TOWN OF LEXINGTON — BOARD OF PUBLIC WORKS
SEWER DIVISION

Sketch of Service Here

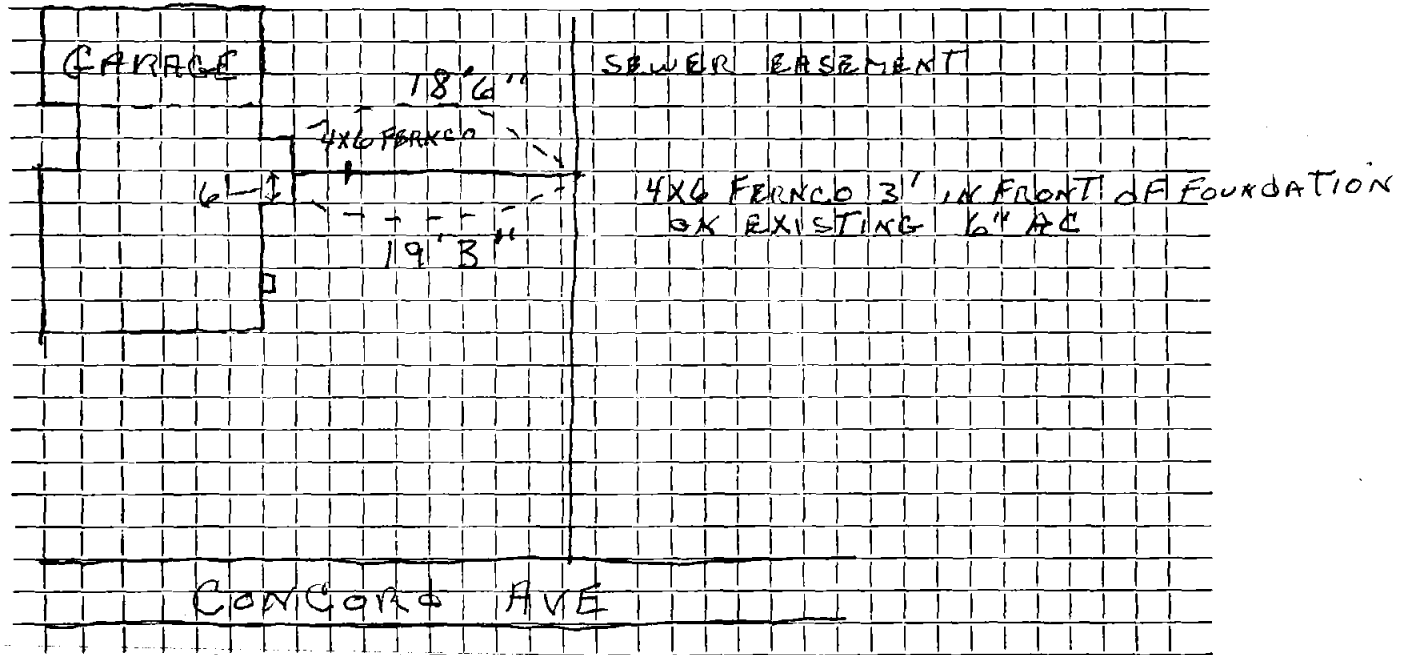

CONCORD AVE

Connection made in EASEMENT..... Street..... Work completed

Remarks: INSTALLED BY J. McLAUGHTON.....