


DATE _____

TOWN OF LEXINGTON — BOARD OF PUBLIC WORKS
SEWER DIVISION

Sketch of Service Here

489

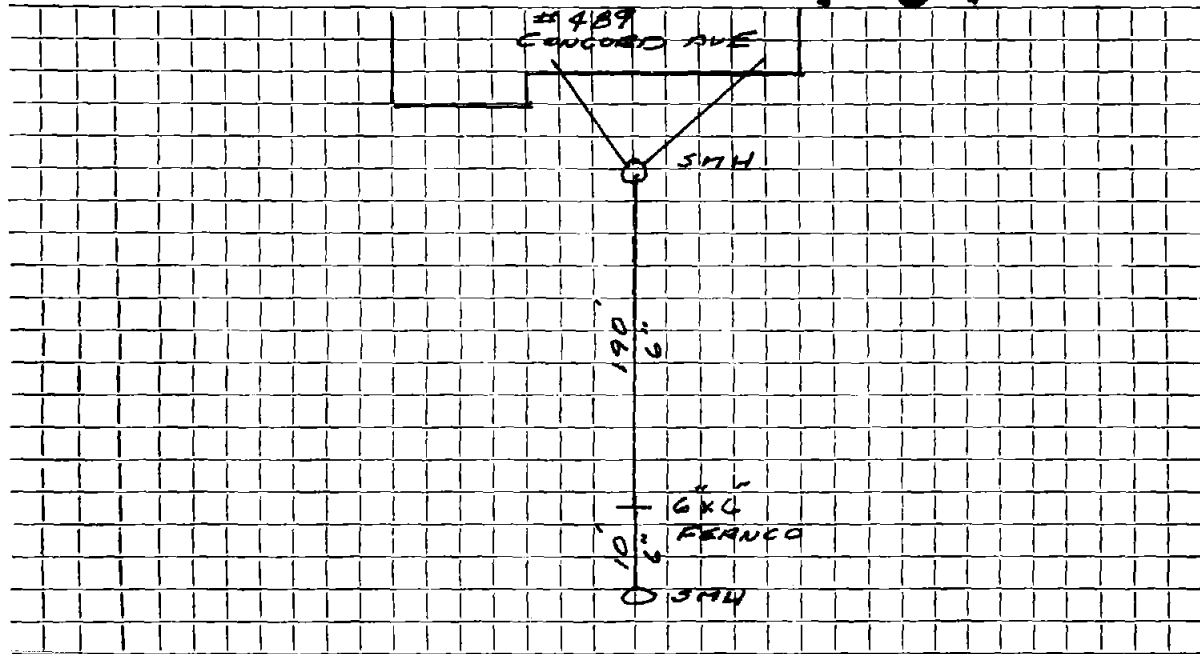

Connection made in EASEMENT Street. Work completed

Remarks: SEWER SERV. THRU #481 LOT