

Name

Service No.

Address

501 Concord Ave.

Lot L.C. 29

Location

Kind of Pipe

Size

Size of Main

Repair—Renewal—New Service

Location

Date	Material	Amount	Total	Date	Amount
1971	15' 6" transite pipe @	12.00	180.00		
				1971	
				15' 6" Transite	
				10-10-74	
				20' 6" Transite	
				1 6"-90° EL	
				1 6" Cap	

Name Mr. Harvey Nugent

Service No. 79

Address 501 Concord Avenue, Lexington

Location

Kind of Pipe

Size

Size of Main

~~Repair Record~~ New Service W.O. # 2621

Location FEB 10 1975

Date	Material	Amount	Total	Date	Amount
10-10-74	Labor	103 48		11-9-74	Deposit 250 00
	10% O.H.	10 35	113 83	5-10-75	* Retund 26 86
20'	6" Transite Pipe	1 24	24 80		223 14
1	90° x 6" El	5 07	5 07		Non-Charge Labor
1	6" Cap	2 89	2 89	10-10-74	Labor 34 51
1/4	Bag Cement	55	55		
1/2	Ton Cold Patch	6 10	6 10		
2	Hrs. Trucking	3 00	6 00		
1	Hr. Pick-Up	1 50	1 50		
2	Hrs. Town Shovel	6 50	13 00		
1	Hr. Compressor	5 00	5 00		
1	10' x 5' Patch		44 40		
			223 14		
					* Applied to W.O. # 34

DATE _____

TOWN OF LEXINGTON — BOARD OF PUBLIC WORKS

SEWER DIVISION

Sketch of Service Here

A large grid of graph paper, approximately 20 columns wide and 25 rows high, intended for sketching service details.

Connection made in Street. Work completed

Remarks:

.....

.....

DATE _____


TOWN OF LEXINGTON — BOARD OF PUBLIC WORKS

SEWER DIVISION

Sketch of Service Here

Lot L.C. 29

501

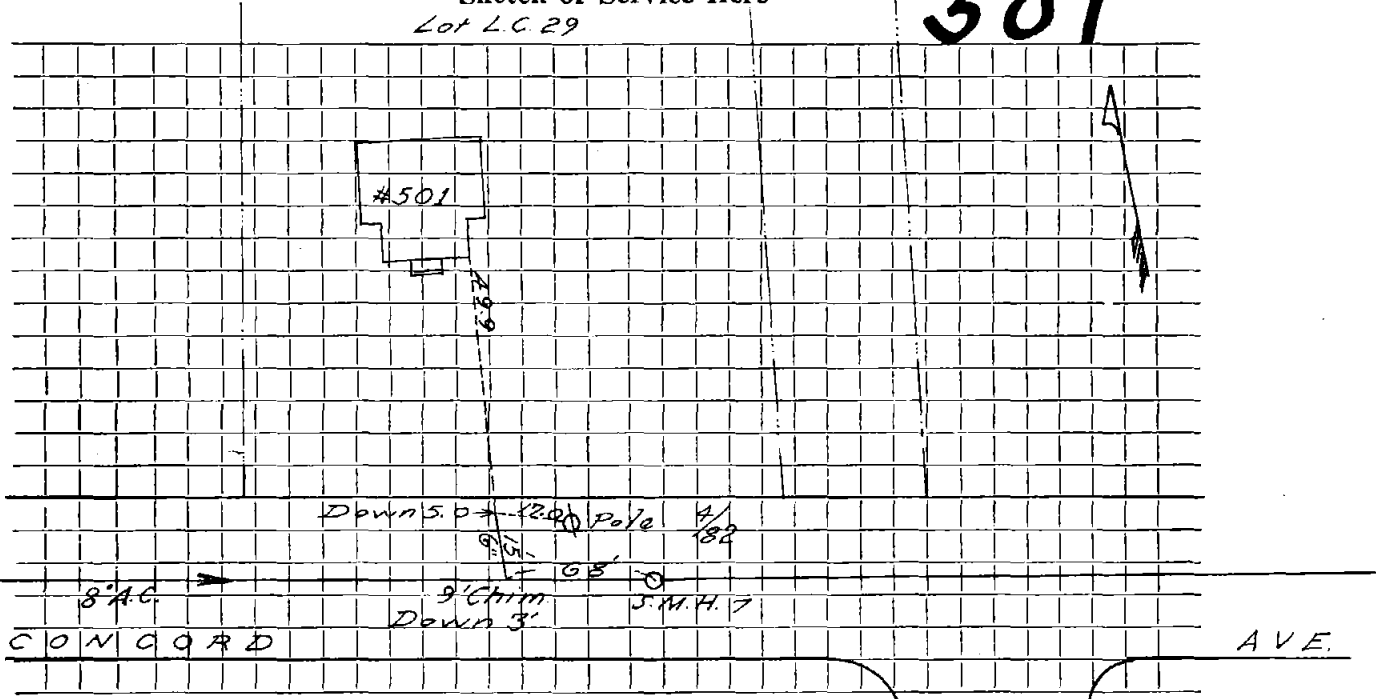

Connection made in Street. Work completed

Remarks:

.....

.....