


DATE 1971

TOWN OF LEXINGTON — BOARD OF PUBLIC WORKS
SEWER DIVISION

Sketch of Service Here 511

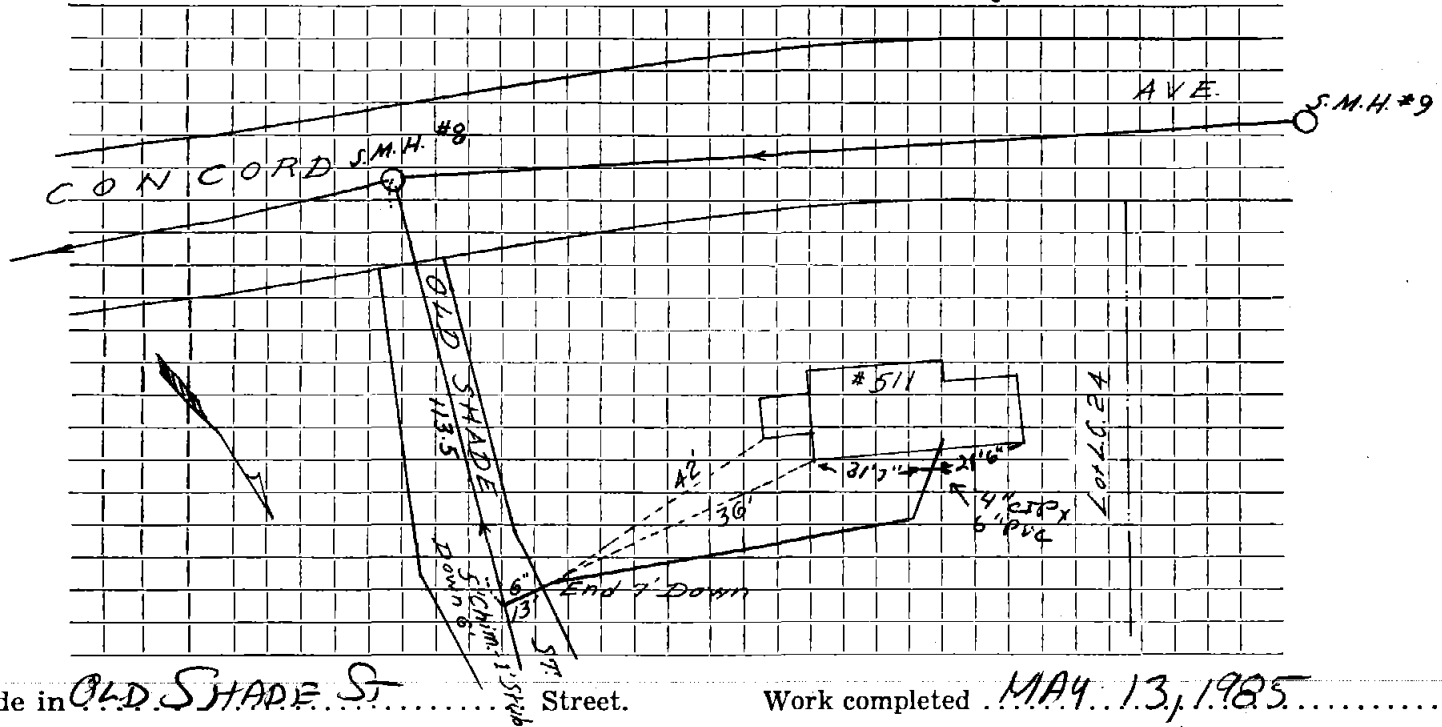

Connection made in OLD SHADE ST. Street. Work completed MAY 13, 1985

Remarks :
.....
.....
.....