

Name

Service No.

Address 5 16 Concord Ave.  
Lot L.C. 56

Location

Kind of Pipe

Size

Size of Main

Repair—Renewal—New Service

Location

Date

Material

Amount

Total

Date

Amount

~~1971 23.6~~ 6" transite pipe @ 12.00 283.20

1971  
23.6 6" Transite

DATE \_\_\_\_\_


TOWN OF LEXINGTON — BOARD OF PUBLIC WORKS

SEWER DIVISION

Sketch of Service Here

516

AVE.

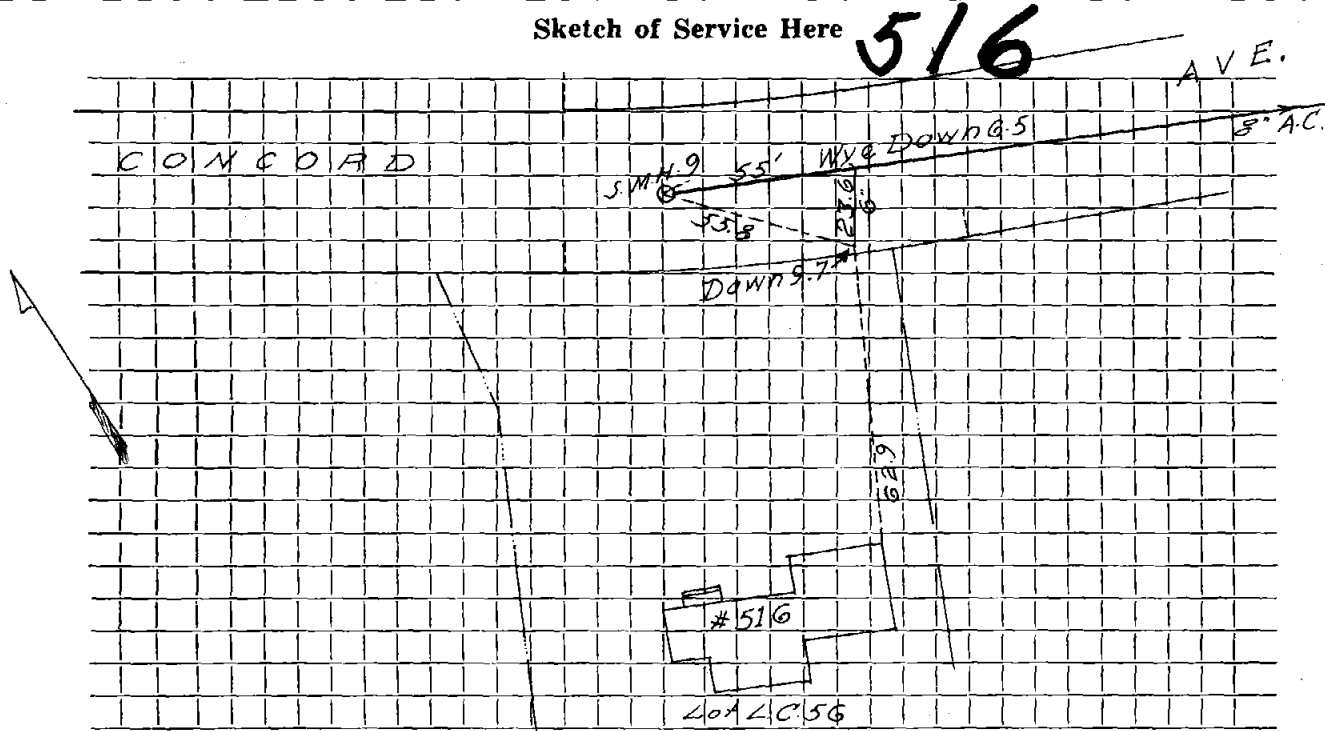

Connection made in ..... Street. Work completed .....

Remarks: .....  
.....  
.....