

Name William L. Collins

Service No. 39

Address 535 Concord Ave.  
Lot L.C. 6

Location

Kind of Pipe

Size

Size of Main

Repair—Renewal—New Service

Bonanno #2025

Location

JUN 5 1972

Date	Material	Amount	Total	Date	Amount
1971	16.5' 6" transite pipe @	12.00	198.00	4-12-72	198.00
4-21-72	37' 6" Transite pipe				
	10' 4" Cast Iron pipe			1971	
				165'	6" Transite

DATE \_\_\_\_\_


# TOWN OF LEXINGTON — BOARD OF PUBLIC WORKS

## SEWER DIVISION

Sketch of Service Here

# 535

Lot L.C. 6

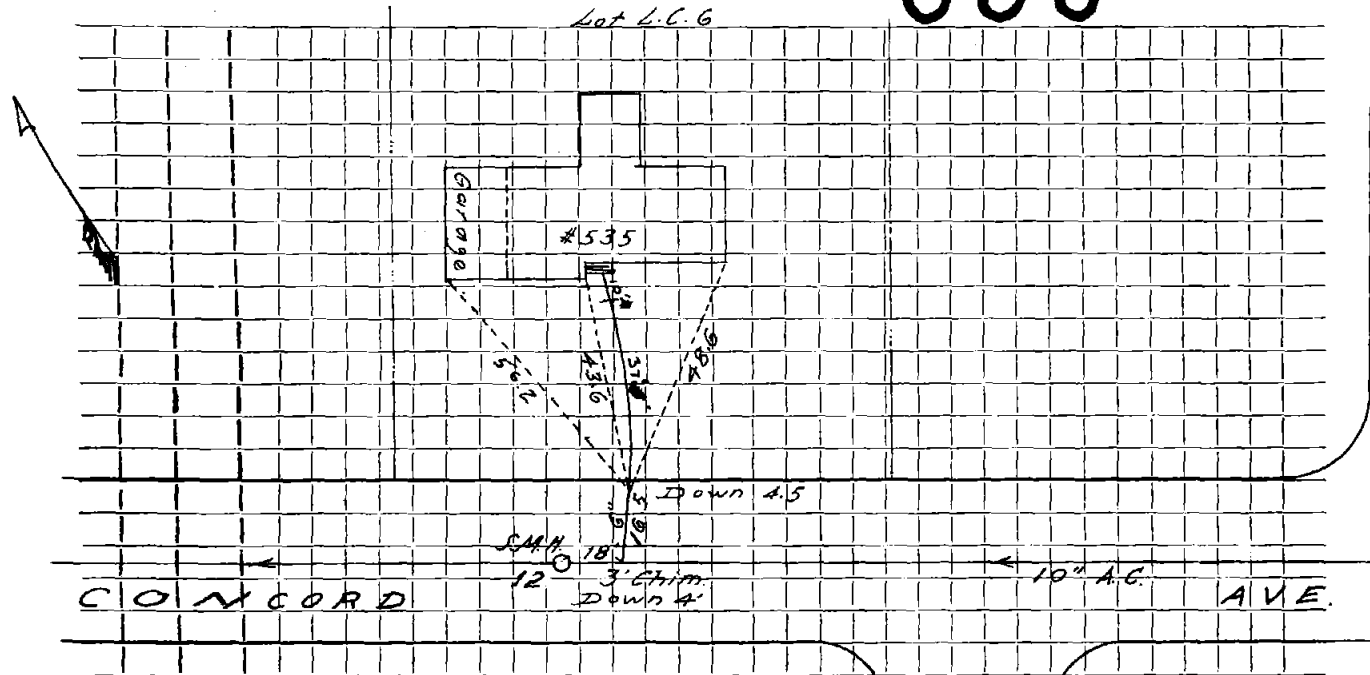

BENJAMIN RD.

Connection made in ..... Street. Work completed .....

Remarks: ..... FIELD

R.D.