

Name Micheal Salhaney

Service No. 69

Address 539 Concord Ave.

Lot L.C. 5

Location

Kind of Pipe

Size

Size of Main

Repair—Renewal—New Service Bonanno #2075


Location AUG 14 1972

Date	Material	Amount	Total	Date	Amount
<del>1971</del>	<del>26' 6" transite pipe @</del>	<del>12.00</del>	<del>312.00</del>	<del>5-22-72</del>	<del>312.00</del>
					Deposit
5/25/72	135' 6" Transite pipe				
	10' 4" Cast Iron pipe			1971	
				26' 6" Transite	

DATE \_\_\_\_\_

TOWN OF LEXINGTON — BOARD OF PUBLIC WORKS  
SEWER DIVISION

Sketch of Service Here **539**

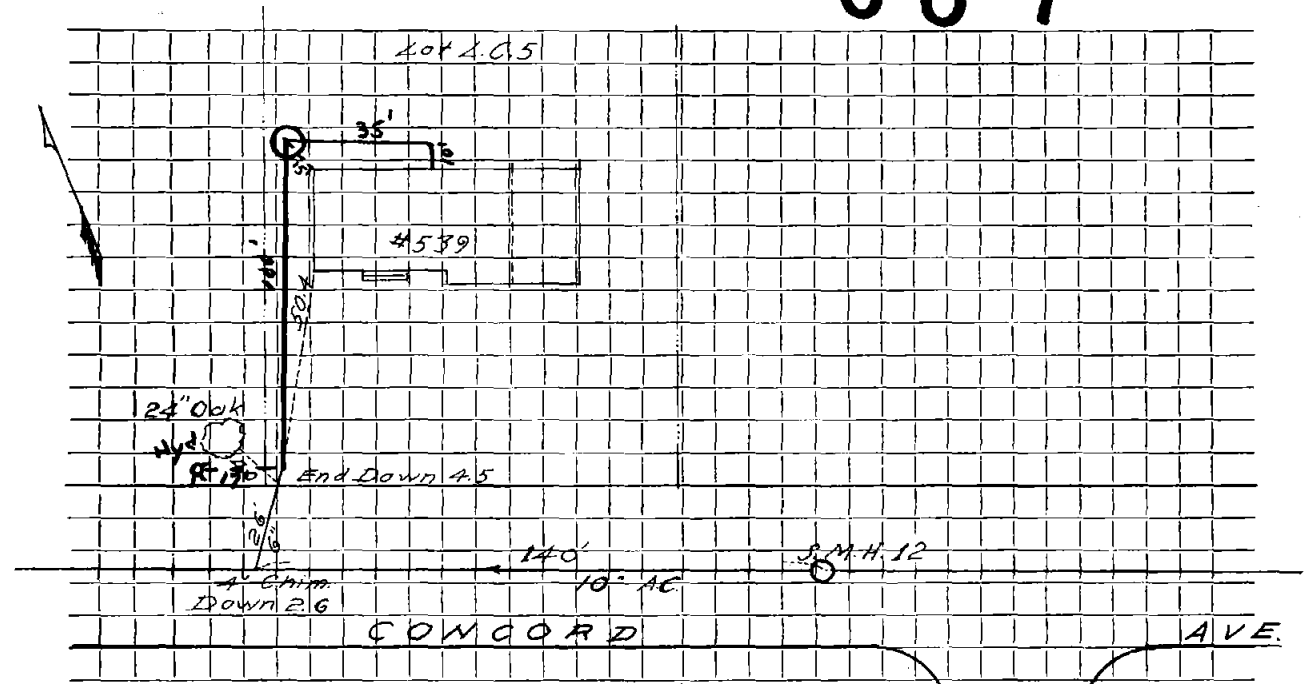

Connection made in ..... Street. Work completed ..... FIELD RD. ....

Remarks: .....  
.....  
.....