

Name Caleb Warner

Service No.

Address

546 Concord Ave.
Lot L.C. 69

Location

Kind of Pipe

Size

Size of Main

Repair—Renewal—New Service

Valeri #2215

Location

Date

Material

Amount

Total

Date

Amount

no previous charge

10/17/72 130' 6" Transite


10' 4" Cast Iron

DATE _____

TOWN OF LEXINGTON — BOARD OF PUBLIC WORKS

SEWER DIVISION

Sketch of Service Here **546**

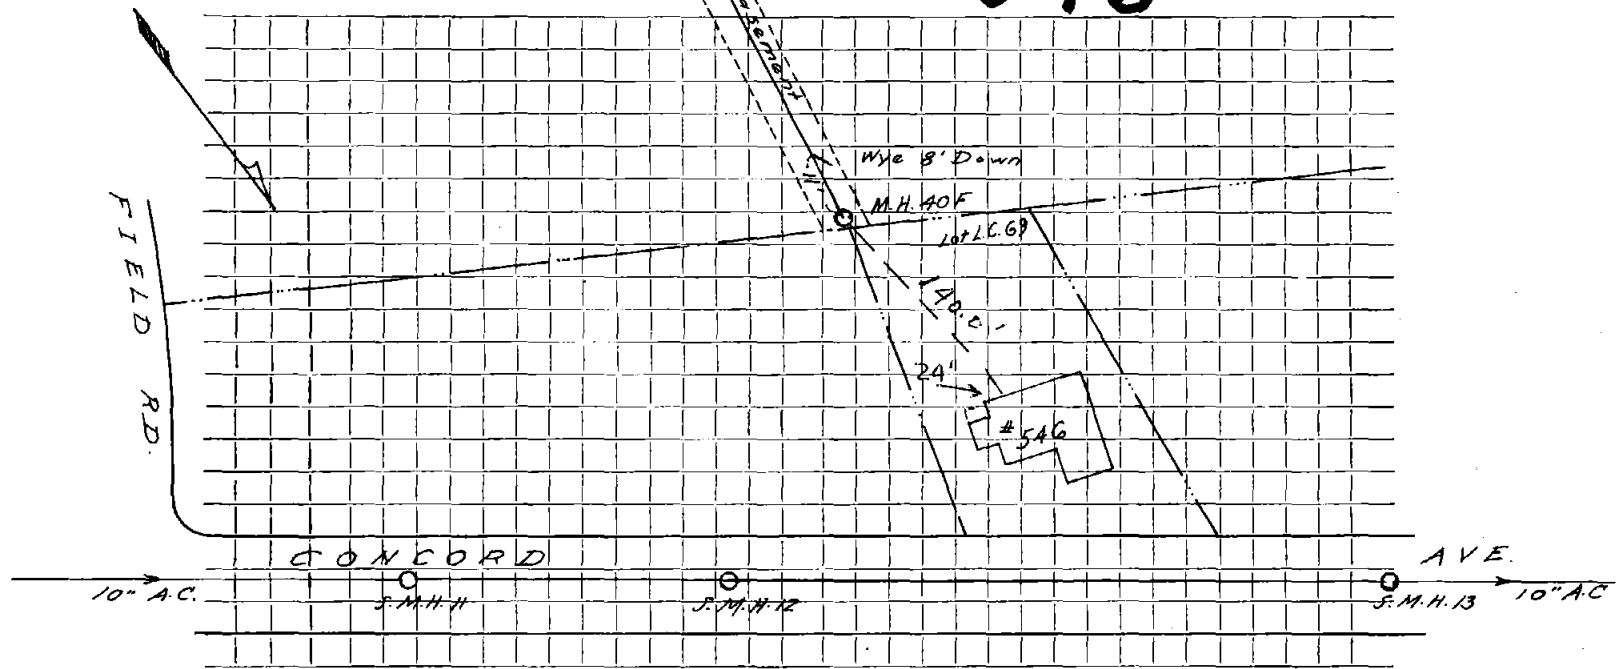

Connection made in Street. Work completed

Remarks:
.....
.....