

Name Daniel I. Pomerantz

Service No. /

Address 552 Concord Ave.

JUN 18 1973

Lot L.C. 68

Location

Kind of Pipe

Size

Size of Main

~~Repair - Deposit~~ New Service

Valeri #2193

Location

Date

Material

Amount

Total

Date

Amount

~~1971~~ 24' 6" transite pipe @ 12.00

288.00

1-19-73

Deposit

288.00

1/19/73 172' 6" Transite

1971

10' 4" Cast Iron

24' 6" Transite


DATE \_\_\_\_\_

# TOWN OF LEXINGTON — BOARD OF PUBLIC WORKS

## SEWER DIVISION

Sketch of Service Here

# 552

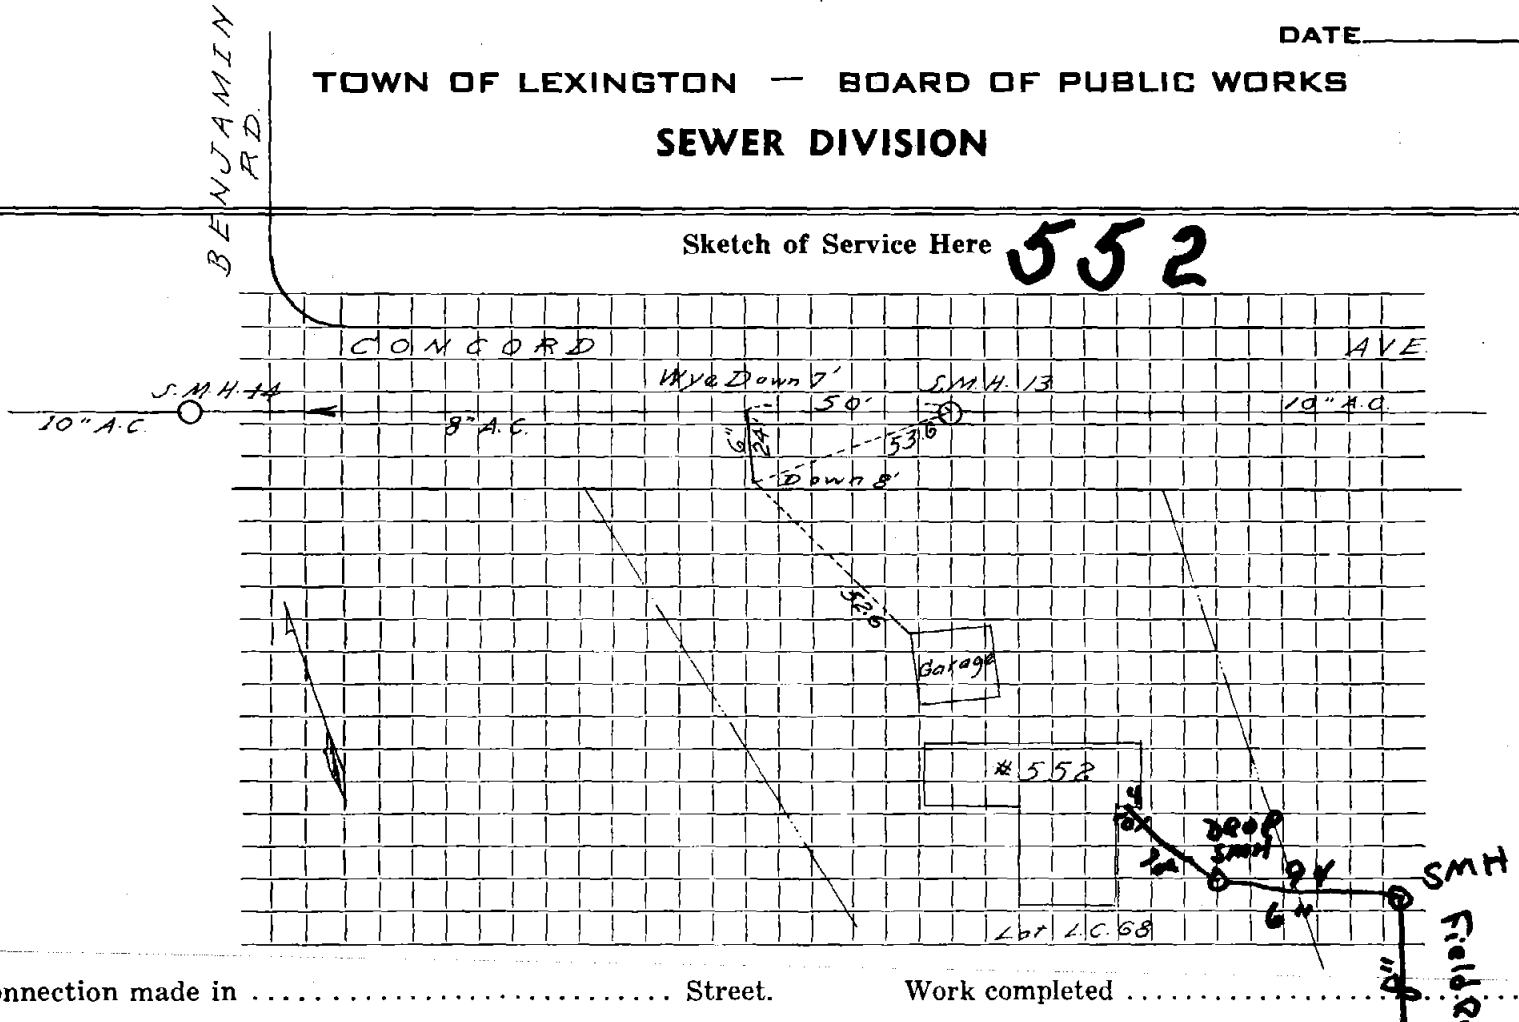

Connection made in ..... Street. Work completed .....

Remarks: .....  
.....  
.....

S.M.H. FIELD: E.A.S.