

Name Ali Fakharzaden

Service No. 63

Address 556 Concord Ave.

Lot 94 assessors Map 11

Location

Kind of Pipe

Size

Size of Main

Remarks ~~Renewal~~ New Service Trebino #3085

Location NOV 13 1978


Date	Material	Amount	Total	Date	Amount
<del>1971</del>	<del>20' 6" transite pipe @ 12.00</del>		<del>240.00</del>	<del>10-10-78</del>	Deposit 455.00
11/20/78	81' 6" Transite Pipe				Refund 185.00
	10' 4" Cast Iron Pipe			1971	240.00
				20' 6" Transite	

DATE \_\_\_\_\_

TOWN OF LEXINGTON — BOARD OF PUBLIC WORKS  
SEWER DIVISION

BENJAMIN RD.  
8" A.C.

Sketch of Service Here **556**

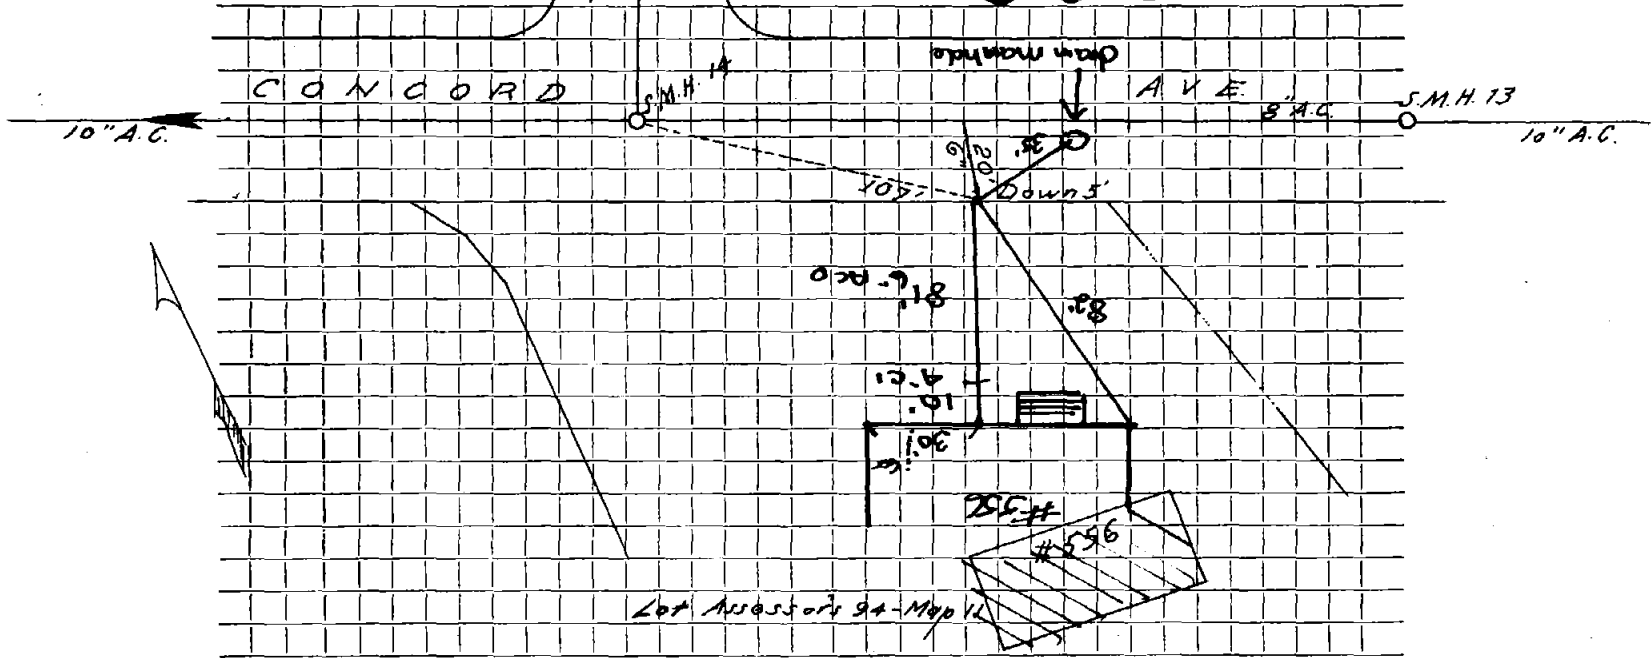

Connection made in ..... Street. Work completed .....

Remarks: .....  
.....  
.....