

Name William J. Hamilton

Service No. 6

Address 558 Concord Avenue

Lot L.C. 80

Location

Kind of Pipe

Size

Size of Main

Repair—Renewal—New Service Valeri #1995

Location


Date	Material	Amount	Total	Date		Amount
1971	23' 6" Transite pipe @	12.00	276.00	12-3-71	<i>Deposit</i>	<i>276.00</i>
1-11-72	47' 6" Transite pipe					
	10' 4" Cast Iron pipe			1971	23' 6" Transite	

DATE _____

TOWN OF LEXINGTON — BOARD OF PUBLIC WORKS
SEWER DIVISION

558 Sketch of Service Here

Service As Requested By Owner

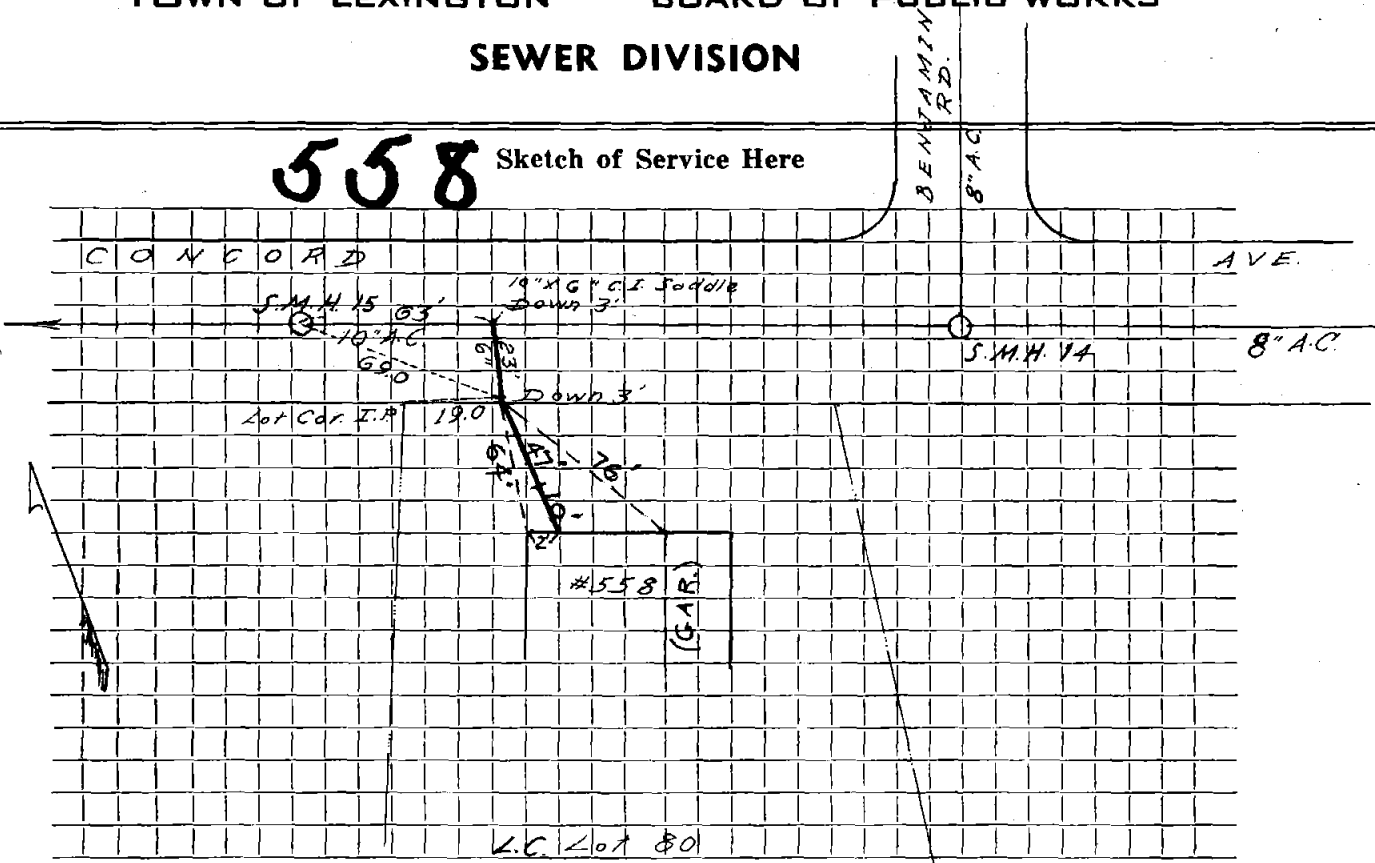

Connection made in Street. Work completed

Remarks:
.....
.....