


DATE 6/19/96

TOWN OF LEXINGTON — BOARD OF PUBLIC WORKS
SEWER DIVISION

Sketch of Service Here **569**

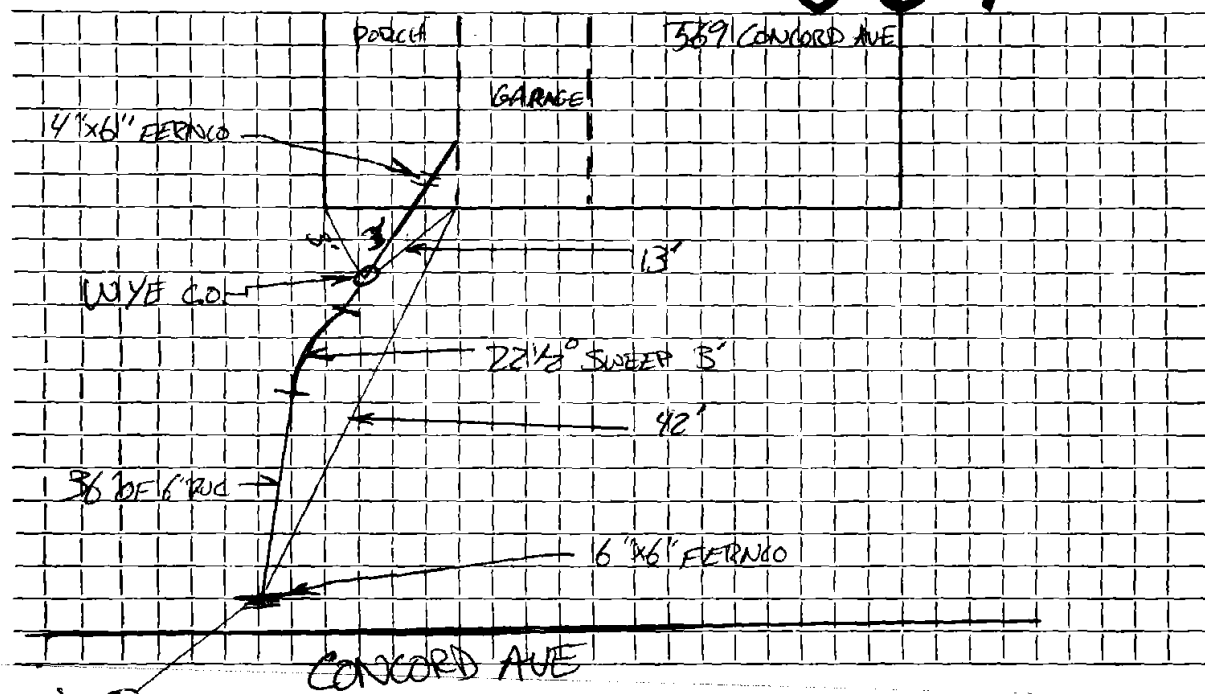

Connection made in FILE # 581 Street. Work completed

Remarks:
.....
.....


DATE _____

TOWN OF LEXINGTON — BOARD OF PUBLIC WORKS

SEWER DIVISION

Sketch of Service Here

569

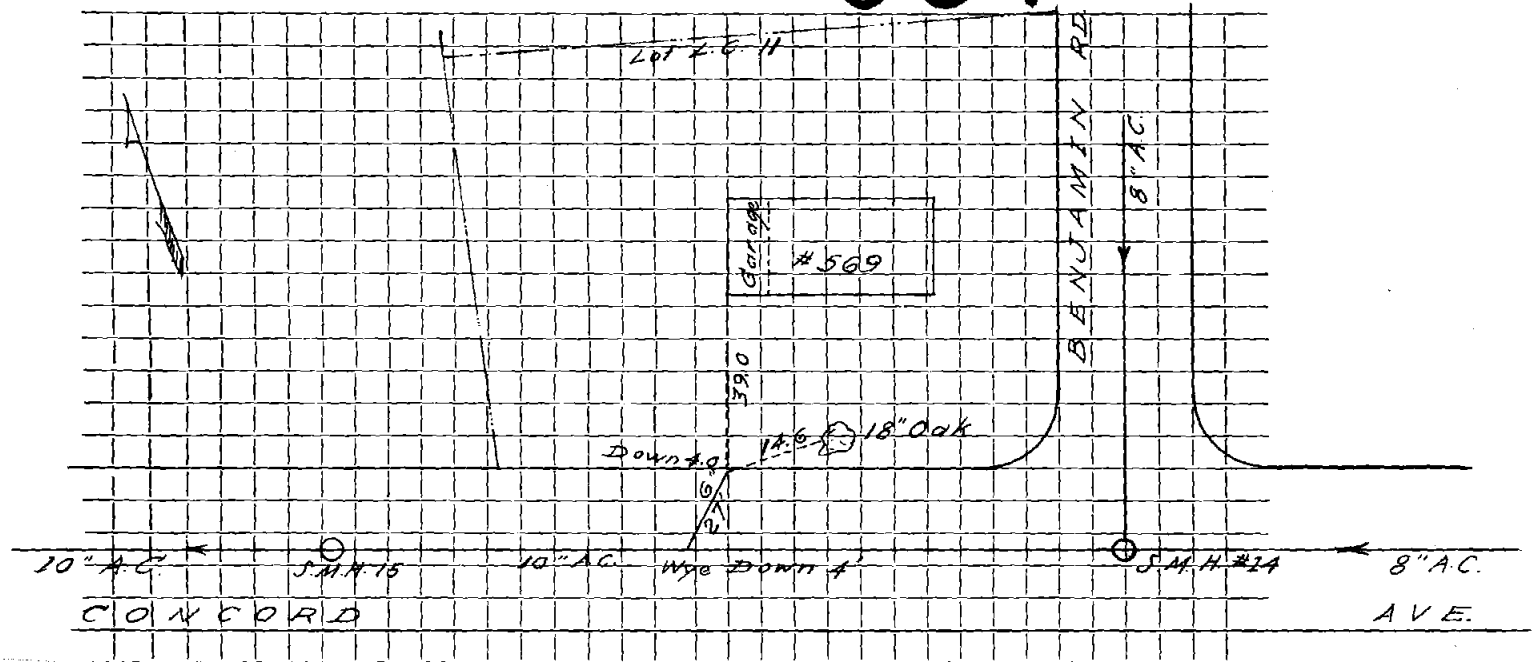

Connection made in Street. Work completed

Remarks:

.....

.....