

Name Drake Park Const.

Service No.

Address 580 Concord Ave

Location

Kind of Pipe

Size

Size of Main

Repair—Renewal—New Service Lucente #2407

Location FEB 10 1975

Date	Material	Amount	Total	Date	Amount
10-25-73	320' 6" Transite pipe				
	10' 4" Cast Iron pipe				
	No Charge				


DATE _____

TOWN OF LEXINGTON — BOARD OF PUBLIC WORKS

SEWER DIVISION

580

Sketch of Service Here

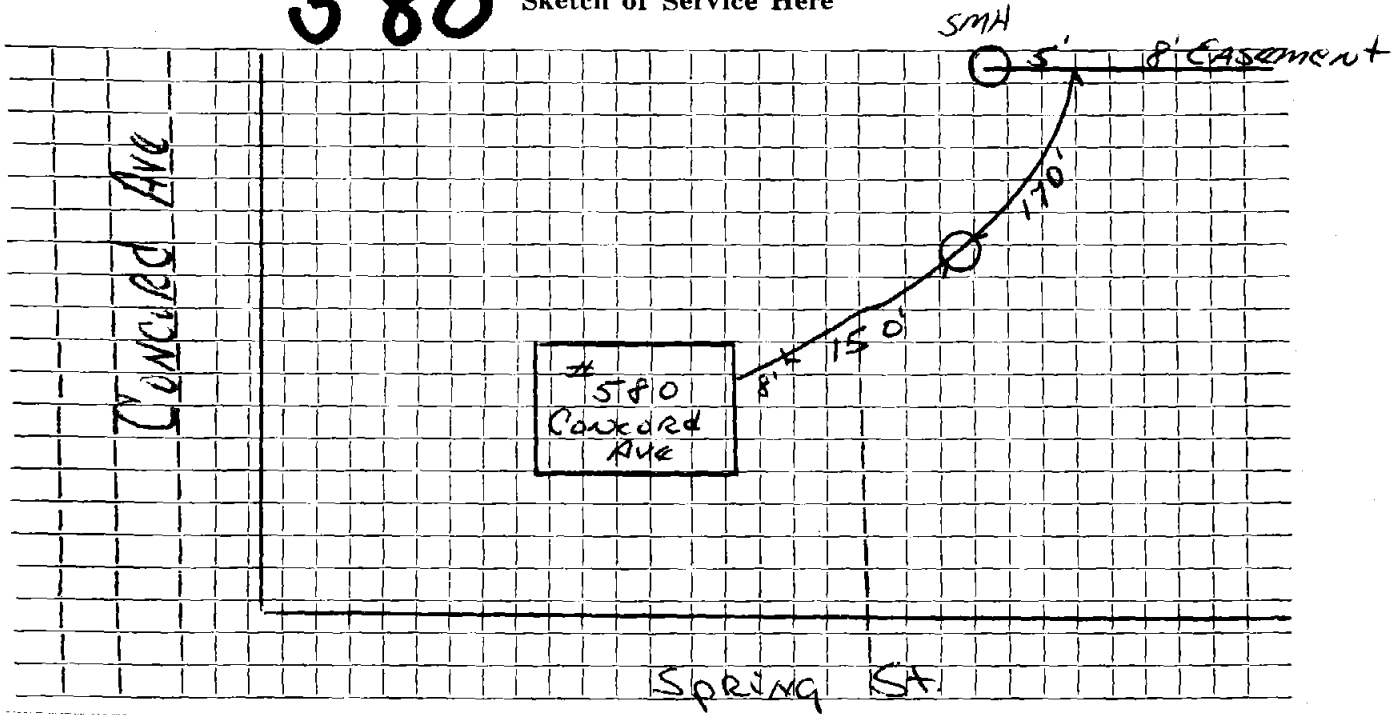

Connection made in Street. Work completed

Remarks:
.....
.....