


DATE 11-18-80

TOWN OF LEXINGTON — BOARD OF PUBLIC WORKS
SEWER DIVISION

75 Sketch of Service Here

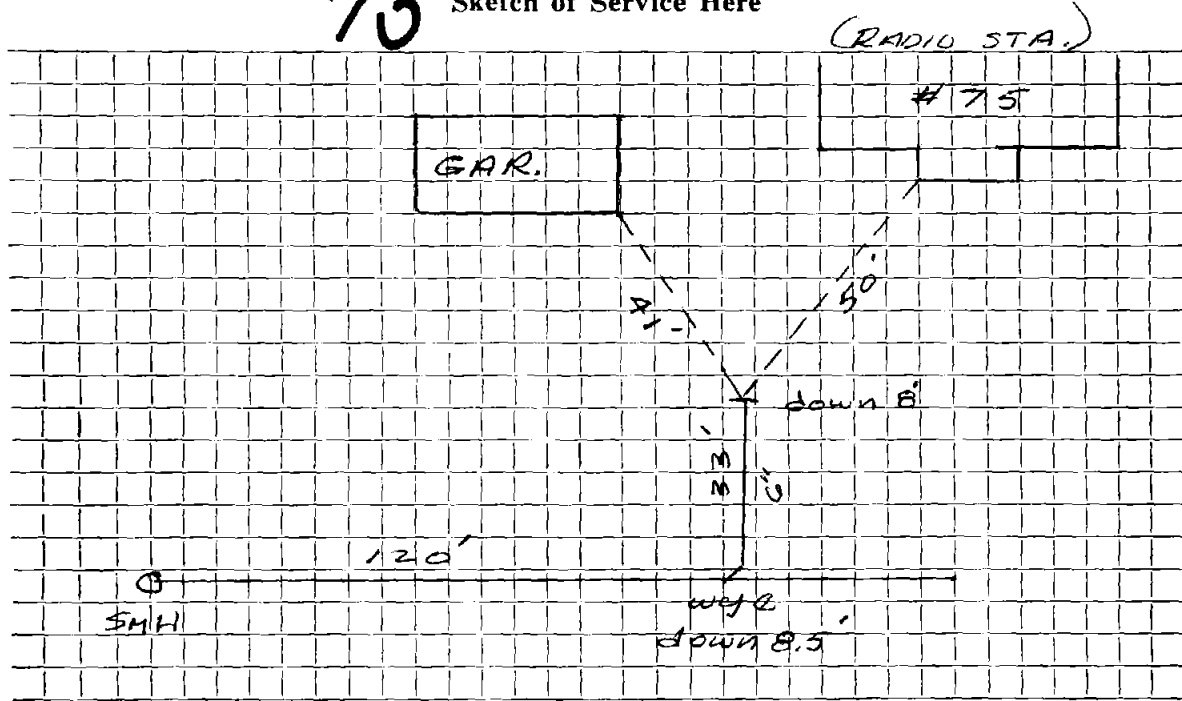

Connection made in CONCORD AVE Street. Work completed

Remarks:

.....

.....