


DATE 11-18-80

TOWN OF LEXINGTON — BOARD OF PUBLIC WORKS
SEWER DIVISION

Sketch of Service Here

94

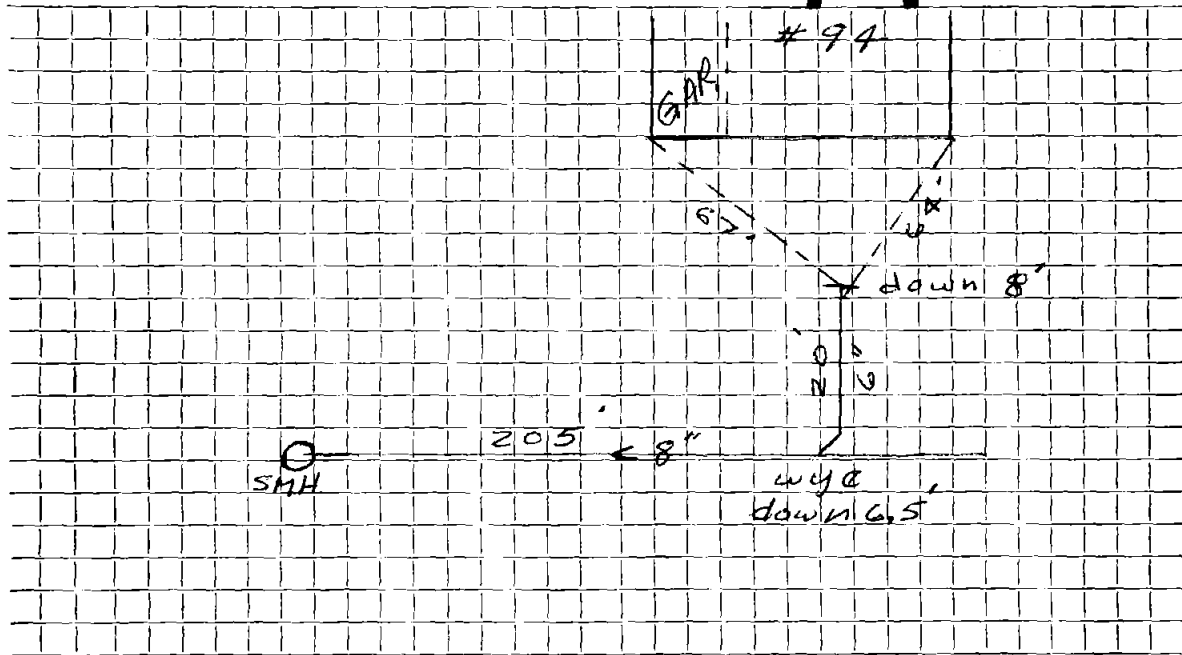

Connection made in CONCORD AVE. Street. Work completed

Remarks:
.....
.....