

Name Lexington Builders

Service No.

Address 353 Concord Avenue (Bldg. #4)

Location

Kind of Pipe

Size

Size of Main

~~REPAIR WORK~~ New Service Oakdale Plumb #3222

Location

Date

Material

Amount

Total

Date

Amount


4-23-79 51 1/2' 4" Cast Iron pipe

DATE _____

TOWN OF LEXINGTON — BOARD OF PUBLIC WORKS

SEWER DIVISION

Sketch of Service Here **353**

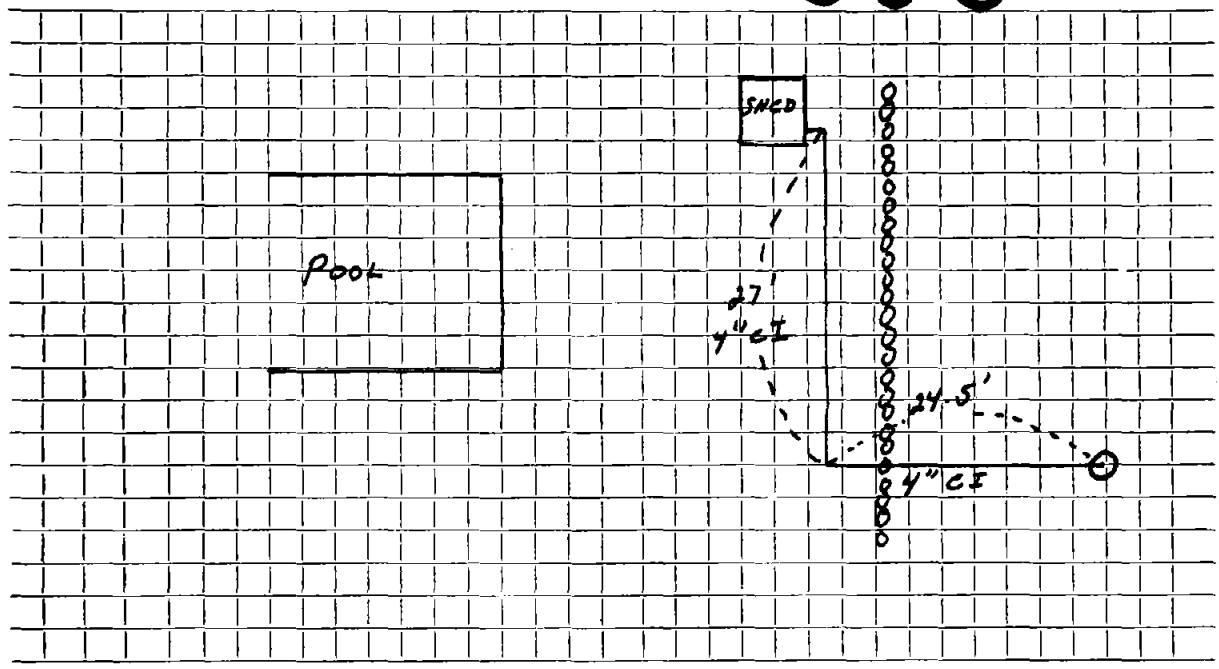

Connection made in Street. Work completed

Remarks:
.....
.....