




DATE 11-18-80

TOWN OF LEXINGTON — BOARD OF PUBLIC WORKS  
SEWER DIVISION

Sketch of Service Here

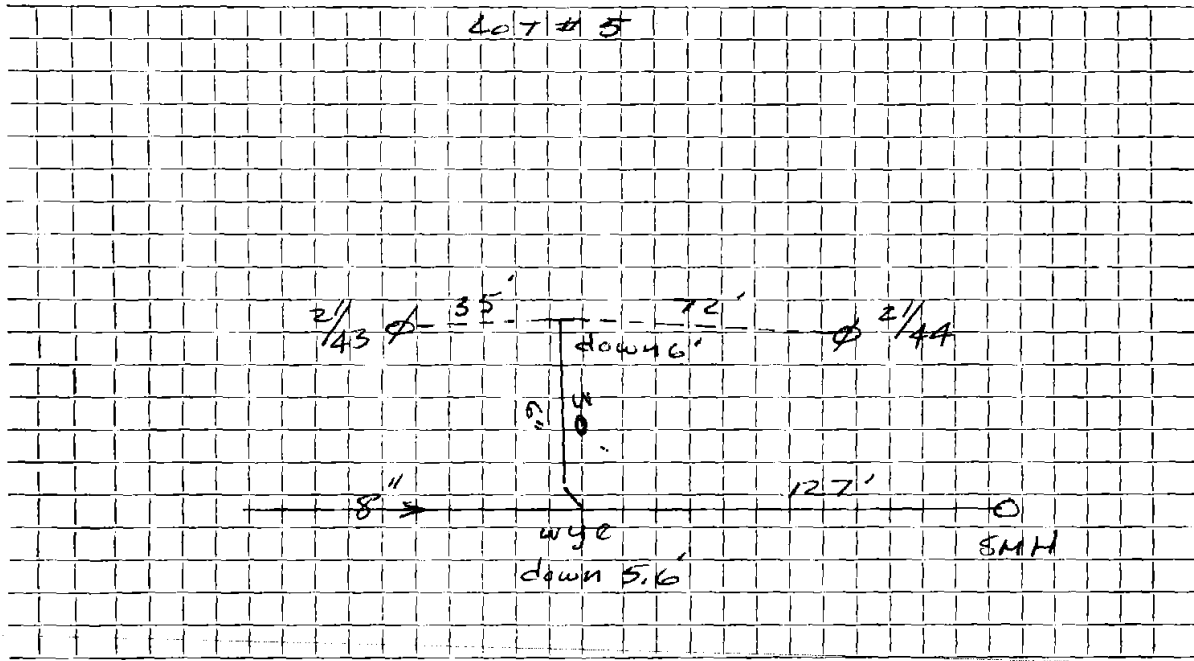

Connection made in CONCORD AVE Street. Work completed .....

Remarks: .....