

Name

Service No.

Address 121 Concord Ave

Permit # 1381

Location

Kind of Pipe

Size

Size of Main

Repair—Renewal—New Service

Location

Date

Material

Amount

Total

Date

Amount

5/1/00

INSIDE

71' 6" PVC

8' 4" PVC

1 4" to 6" FERNCO


1 6" 22 1/2° BEND

1 6" 45° BEND w/CLEAN OUT

DATE 5/1/00

TOWN OF LEXINGTON — BOARD OF PUBLIC WORKS  
SEWER DIVISION

Sketch of Service Here

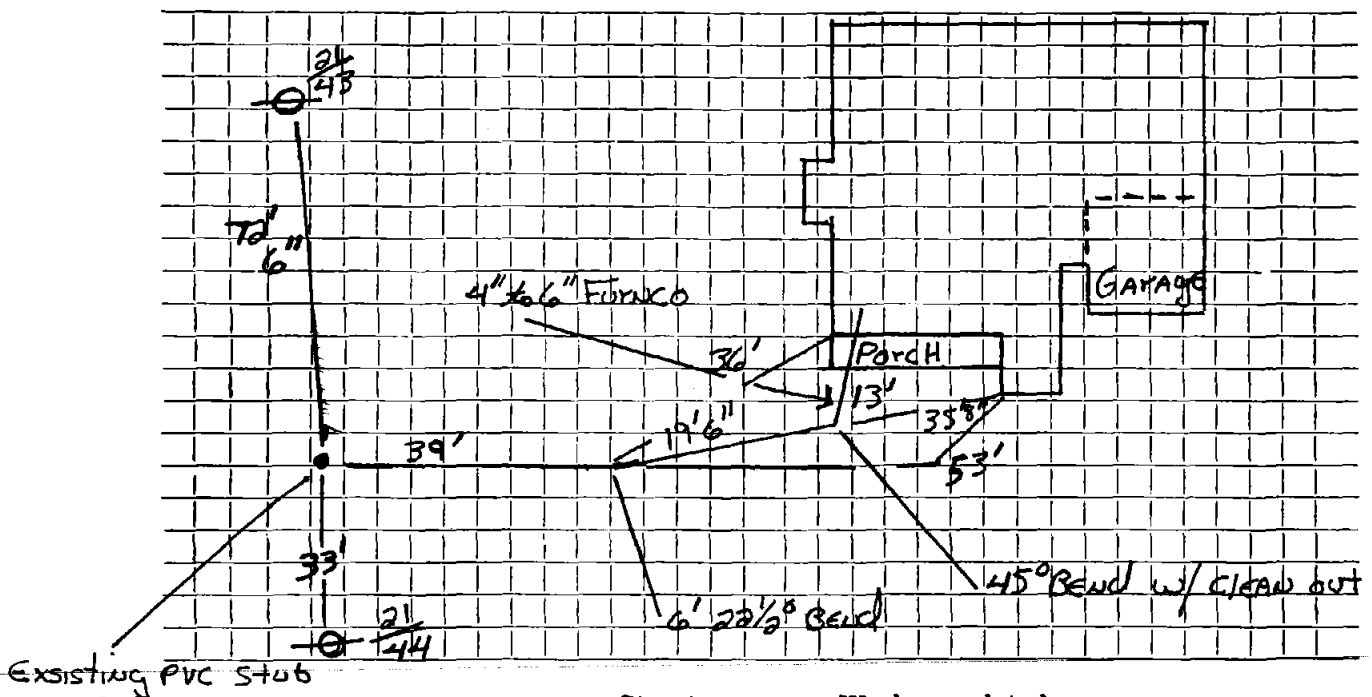

Connection made in ..... Street. Work completed .....

Remarks: .....  
.....  
.....