

Name R. K. Schmidt

Service No.

Address # 11 Conestoga Road

Lot #9

Location

Kind of Pipe

Size

Size of Main

Repair—Renewal—New Service

Sibley #1958
Lucente #930

Location

Date	Material	Amount	Total	Date	Amount
------	----------	--------	-------	------	--------

~~11/6/67~~ 30' 6" Transite Pipe

12/21/71 53' 6" Transite pipe

10' 4" Cast Iron


11-6-67

30' 6" Transite

DATE _____

TOWN OF LEXINGTON — BOARD OF PUBLIC WORKS
SEWER DIVISION

Sketch of Service Here //

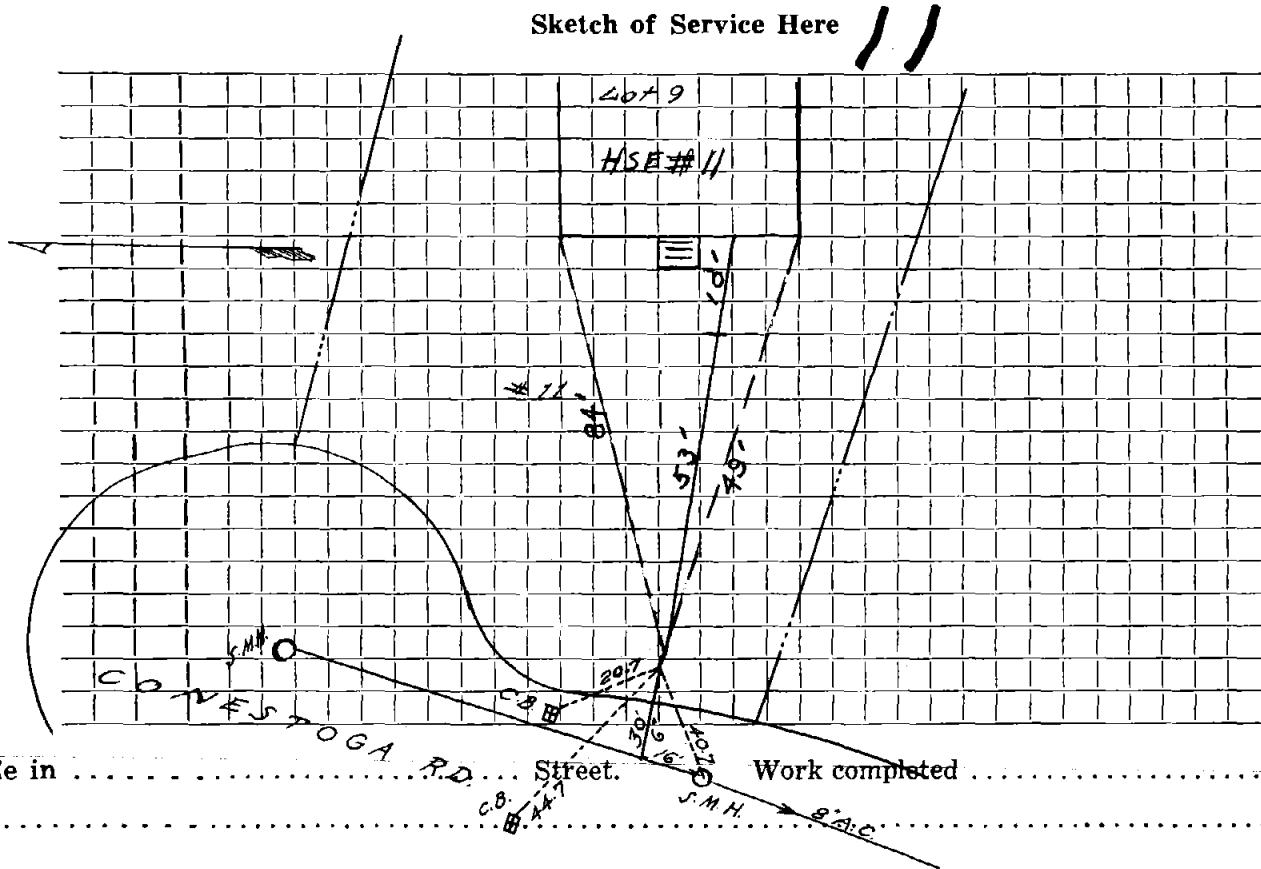

Connection made in _____ Street. Work completed _____

Remarks: _____

