

Name Earl Outhet (Mail to 25 Ivan Street)

Service No.

Address 2 Conestoga Road

Lot # 3

Location

Kind of Pipe

Size

Size of Main

Repair—Renewal—New Service DeFelice Brothers # 975


Location

Date	Material	Amount	Total	Date	Amount
1968 35'	6" Transite Pipe				
10'	4" Cast Iron				
				11-9-67	
				30' 6" Transite	

DATE _____

TOWN OF LEXINGTON — BOARD OF PUBLIC WORKS
SEWER DIVISION

Sketch of Service Here **2**

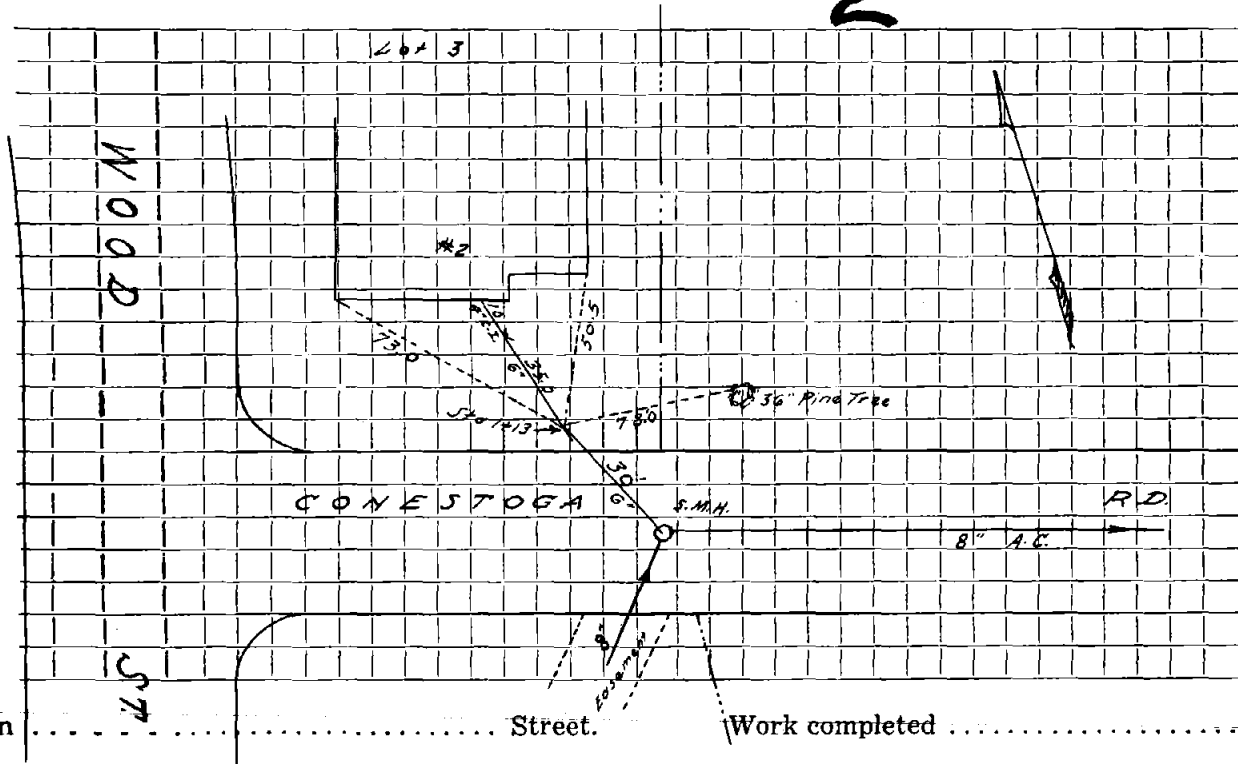

Connection made in Street. Work completed

Remarks:
.....
.....