

DATE 3/10/23

TOWN OF LEXINGTON — BOARD OF PUBLIC WORKS
SEWER DIVISION

Sketch of Service Here

A 10' cover

B 8' cover

SMH-A 31'


SMH-B 70.5'

SMH-C 76'

E-C 14.5'

D-B 10'

6" PVC
Sewer

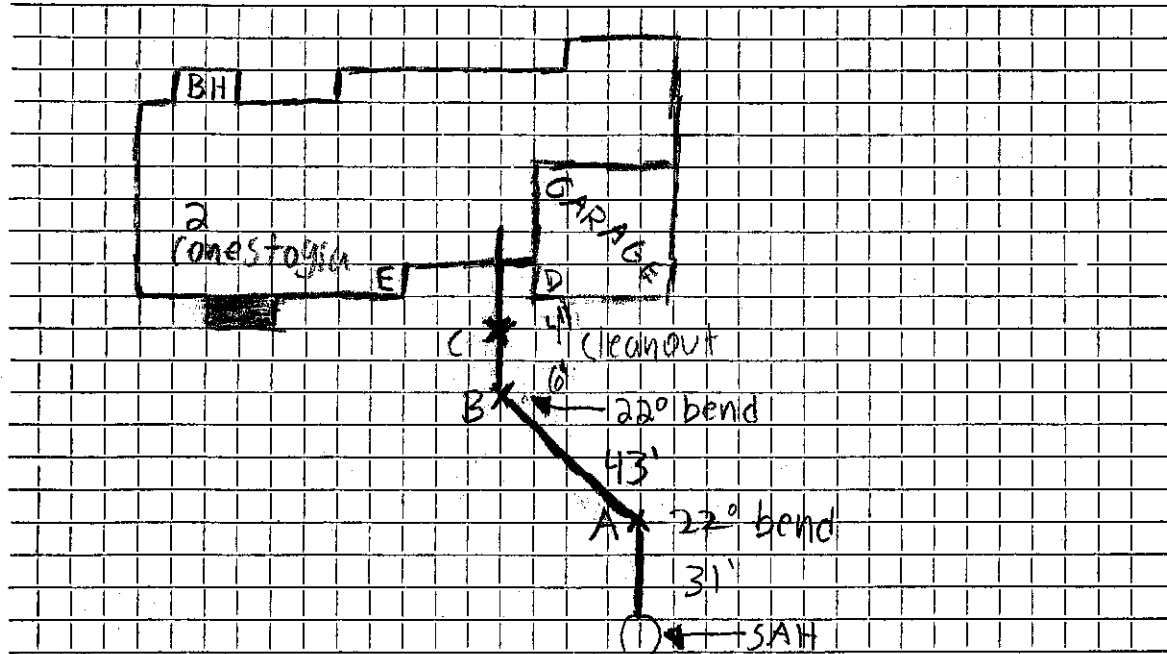

Connection made in Street.

Work completed .. UTICON INC

Remarks: