

Name *Homes Realty*

Service No.

Address *3 Conestoga Road*

Lor #13

Location

Kind of Pipe

Size

Size of Main

Repair—Renewal—New Service *Lucente 926 McLaughlin #0220*

Location


| Date | Material | Amount | Total | Date | Amount |
|-----------------|--------------------------------|--------|-------|------------------------|--------|
| <i>11/6/67</i> | <i>30' 6" Transite Pipe</i> | | | | |
| <i>12/21/92</i> | <i>44' 6" PVC</i> | | | | |
| | <i>1 6" PVC x 6" AC Fernco</i> | | | <i>11-6-67</i> | |
| | | | | <i>30' 6" Transite</i> | |
| | | | | | |
| | | | | | |
DATE _____

TOWN OF LEXINGTON — BOARD OF PUBLIC WORKS

SEWER DIVISION

Sketch of Service Here **3**

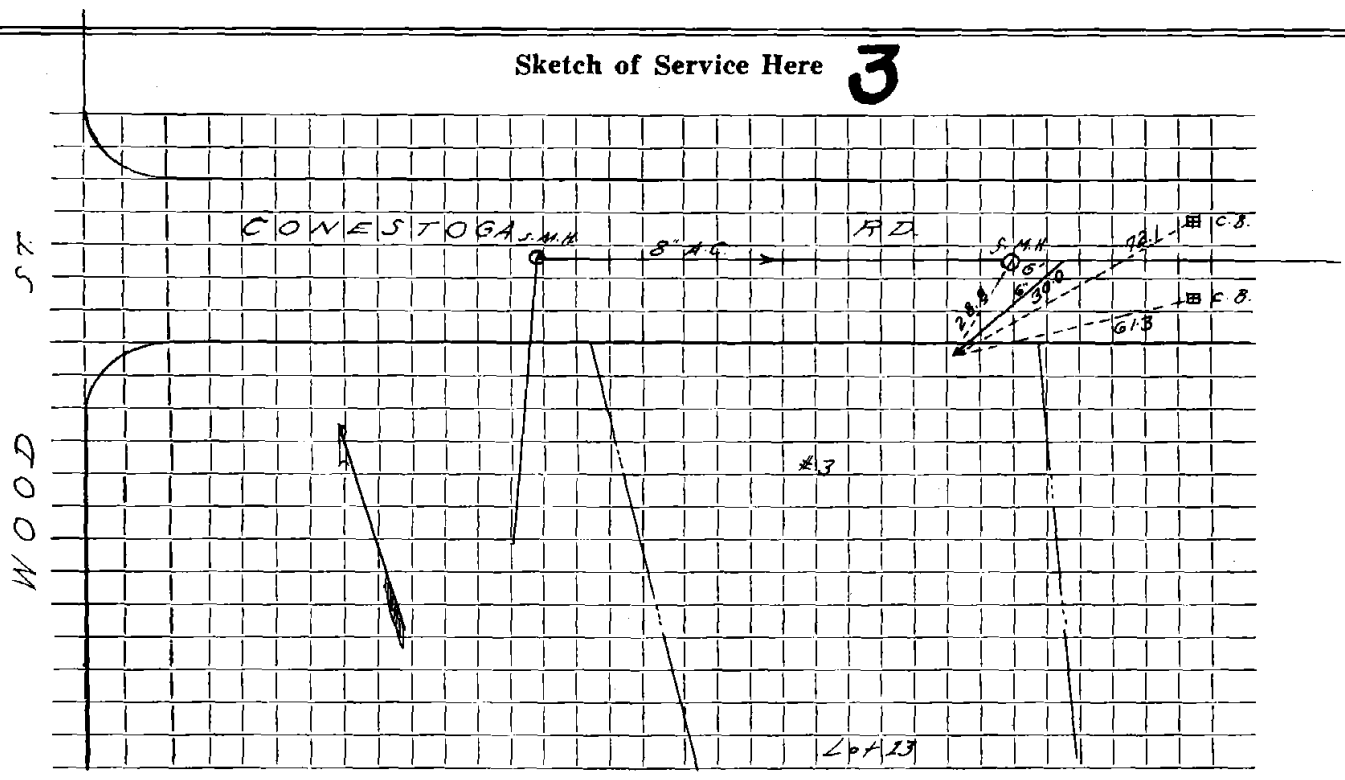

Connection made in Street. Work completed

Remarks:
.....
.....