

Name

R. K. Schmidt

Service No.

Address

4 Conestoga Road

Lot #4

Location

Kind of Pipe

Size

Size of Main

Repair—Renewal—New Service

Sibley # 1956  
Lucente #936

Location

Date

Material

Amount

Total

Date

Amount

~~12/4/67~~ 30' 6" Transite Pipe

12/21/71 54' 6" Transite pipe

10' 4" Cast Iron

12-4-67

30' 6" Transite


DATE \_\_\_\_\_

# TOWN OF LEXINGTON — BOARD OF PUBLIC WORKS

## SEWER DIVISION

Sketch of Service Here

# 4

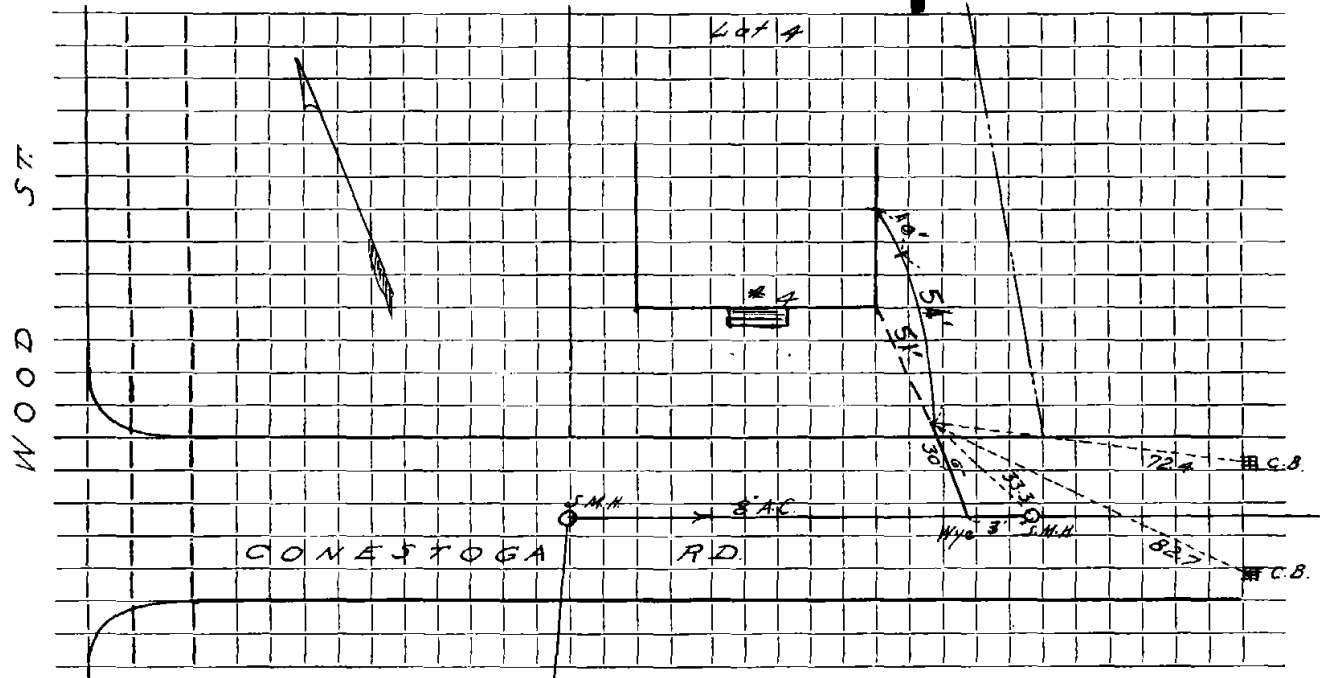

Connection made in ..... Street. Work completed .....

Remarks: .....  
.....  
.....