

Name Robert Breslin

Service No.

Address 7 Conestoga Road

Lot #11

Location

Kind of Pipe

Size

Size of Main

Repair—Renewal—New Service

DeFlice #1280
Lucente #928


Location

Date	Material	Amount	Total	Date	Amount
11/6/67	30' 6" Transite Pipe				
12-17-68	37' 6" Transite pipe				
	10' 4" Cast Iron pipe			11-6-67	
				30' 6" Transite	

DATE _____

TOWN OF LEXINGTON — BOARD OF PUBLIC WORKS
SEWER DIVISION

Sketch of Service Here **7**

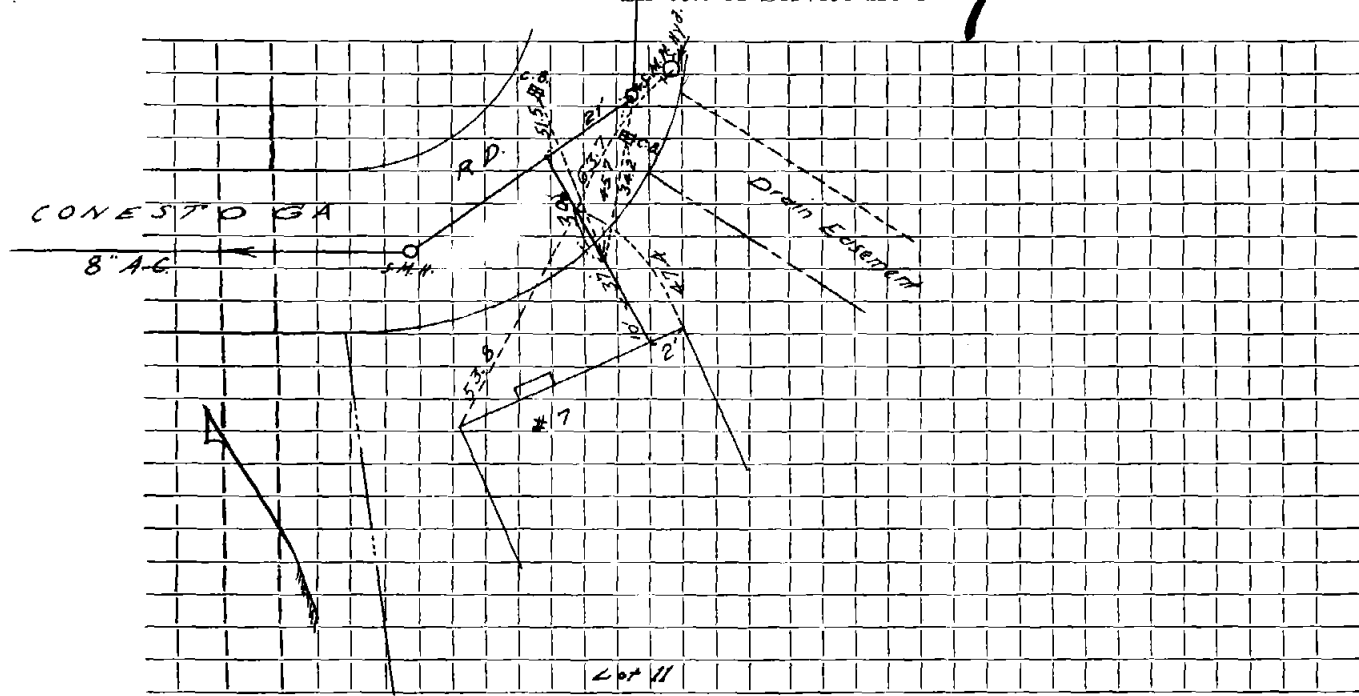

Connection made in Street. Work completed

Remarks:
.....
.....