

Name

R. K. Schmidt *Nathan Klein*

Service No.

Address

9 Conestoga Road

Lot # 10

Location

Kind of Pipe

Size

Size of Main

Repair—Renewal—New Service

Sibley # 1957

Lucente #929

*Grieci #2805*

Location

Date

Material

Amount

Total

Date

Amount

~~11/6/67~~ 21' 6" Transite Pipe

12/8/71 67' 6" Transite pipe

10' 4" Cast Iron

8/25/76 59' 6" Transite Pipe

10' 4" Cast Iron

*11-6-67*

*21' 6" Transite*

*8-16-75*

*7-2-75*

*Solids  
Solids*


DATE \_\_\_\_\_

# TOWN OF LEXINGTON — BOARD OF PUBLIC WORKS

## SEWER DIVISION

Sketch of Service Here

9  
S.M.H.  
195  
145

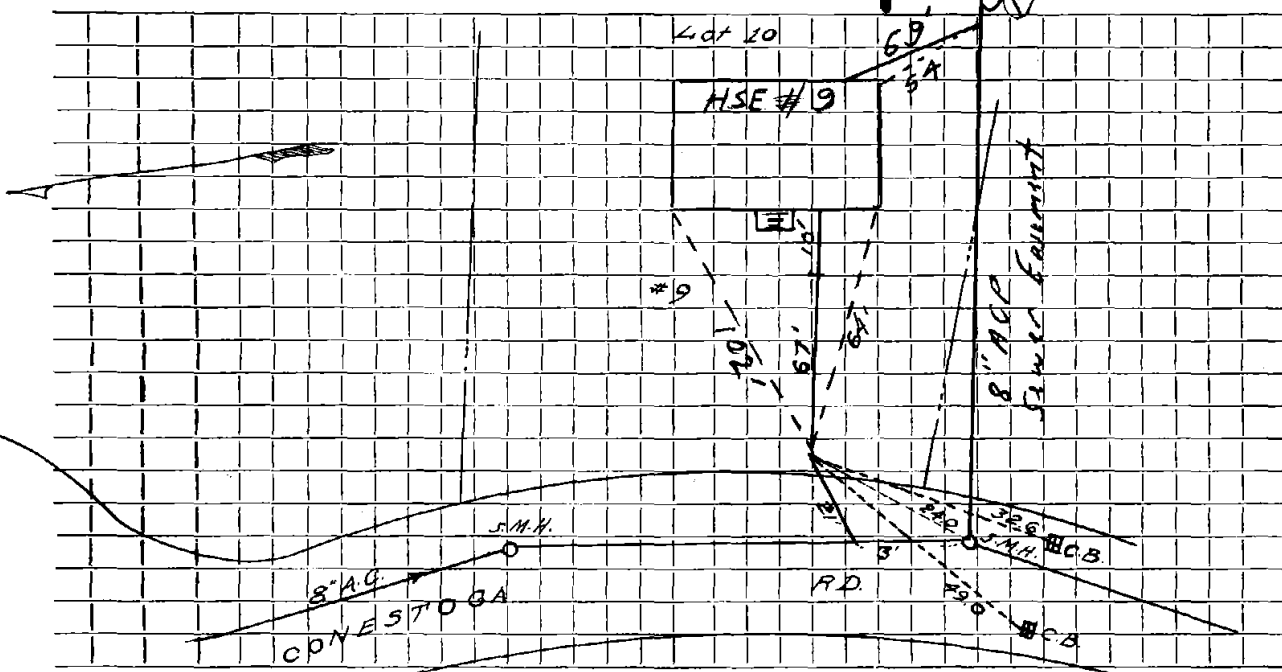

Connection made in Sewer Eastment Street. Work completed \_\_\_\_\_

Remarks: \_\_\_\_\_  
\_\_\_\_\_  
\_\_\_\_\_