

Name Leeland Construction Co.

Service No. 125

Address 1 Constitution Road

Location

Kind of Pipe

Size

Size of Main

~~Repair - Renewal~~ New Service W.O. #8218

Location *Comm 2-10-64*


Date	Material	Amount	Total	Date		Amount
10/11/63	Labor	85 16		10-1-63	Deposit	22.50
	10% O.H.	8 52	93 68	2-10-64	Retained	39 51
	46' 6" Transite Pipe @ .82		37 72			185 49
	1 6" Transite Elbow		4 09			
	1 Bag Cement		1 50			
	5 Hrs. Town Shovel @ 6.50		32 50			
	2 Hrs. Trucking @ 3.00		6 00			
	10 X 3 Patch		10 00			
			185 49			

DATE _____

TOWN OF LEXINGTON — BOARD OF PUBLIC WORKS

SEWER DIVISION

Sketch of Service Here

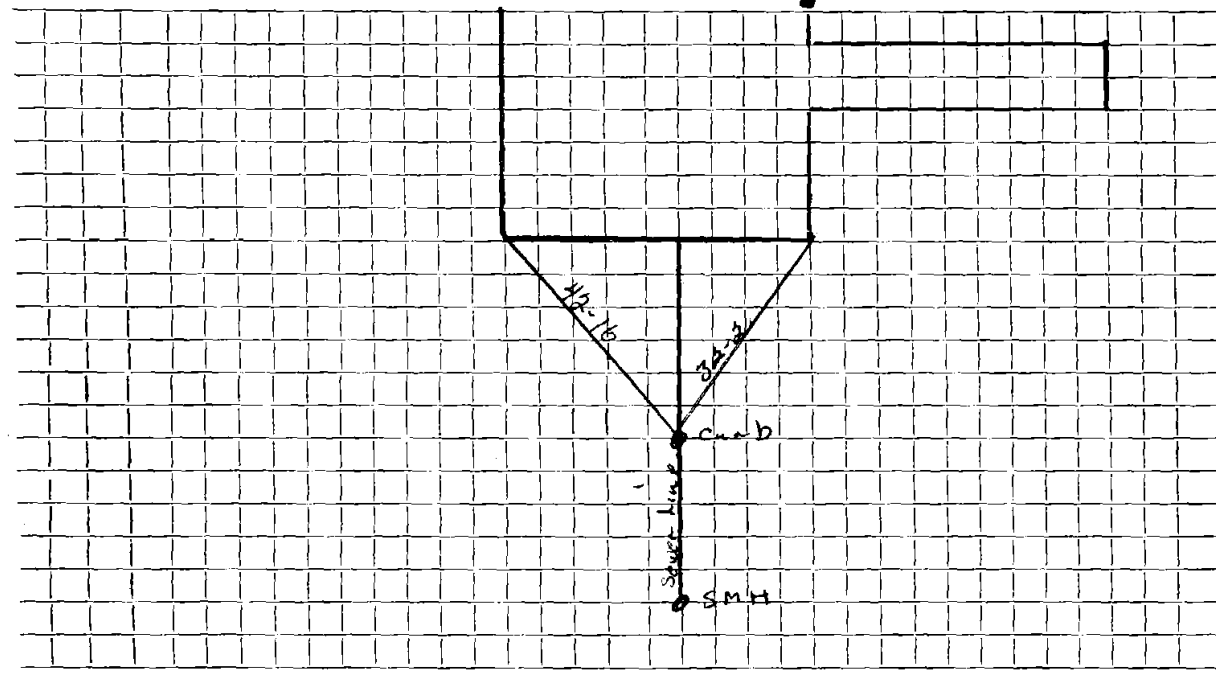

Connection made in Street. Work completed

Remarks:
.....
.....