

Name Albert Berger

Service No. 60

Address #11 Constitution Rd.

Location

Kind of Pipe

Size

Size of Main

~~Repair/Resewer~~ New Service WO # 8001


Location Comm 10-28-63

Date	Material	Amount	Total	Date		Amount
6-10-63	Labor	95.15		6-4-63	Deposit	250 00
	10% O.H.	9.52	104.67	10-28-63	Refund	35 60
	52' 6" Transite pipe @.82		42.64			214 40
	1 90° Transite Elbow		4.09			
	8 yds. Loam @3.00		24.00			
	15 x 3 Patch		15.00			
	2 hrs. Town Shovel @6.50		13.00			
	2 hrs. Trucking @3.00		6.00			
	1 hr. Loader @5.00		5.00			
			214.40			

DATE _____

TOWN OF LEXINGTON — BOARD OF PUBLIC WORKS
SEWER DIVISION

Sketch of Service Here //

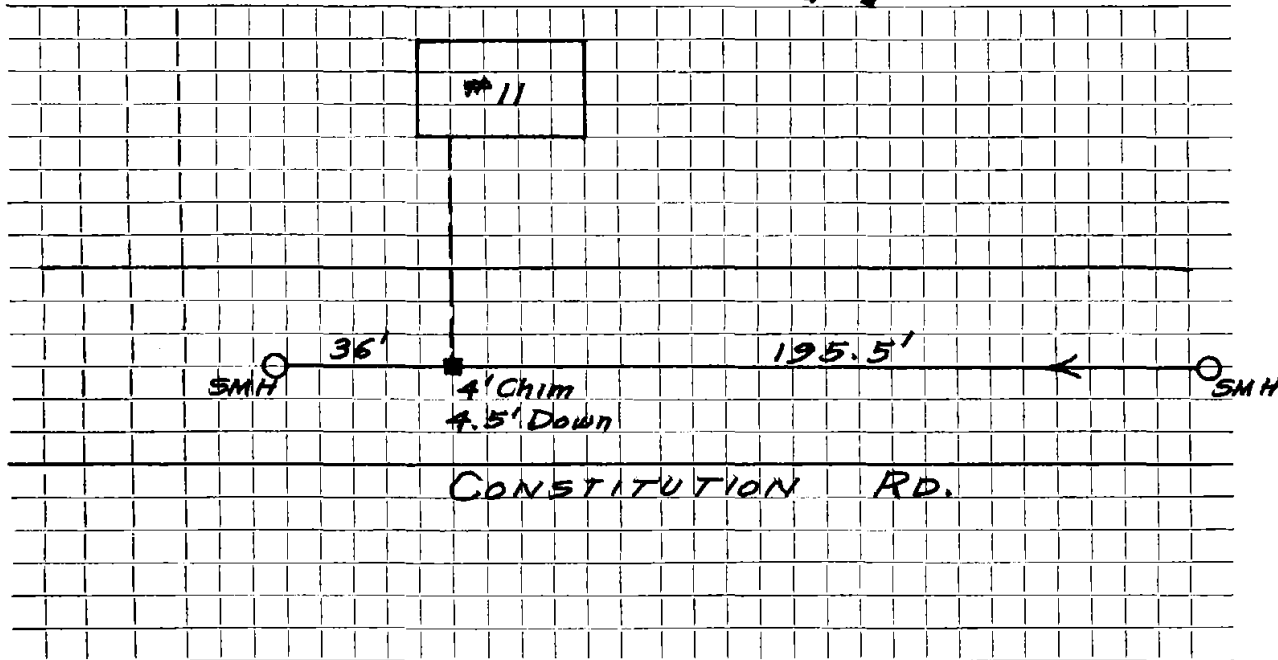

Connection made in Street. Work completed

Remarks:
.....
.....