

Name Samuel T. Church

Service No. 106

Address #12 Constitution Rd.

Location

Kind of Pipe

Size

Size of Main


~~Renewal~~—New Service W.O. #8138Location *Comm 2-10-64*

Date	Material	Amount	Total	Date	Amount
9/17/63	Labor	52 02		8-23-63	250 00
9/18/63	"	74 02		3-24-64	25 38
9/19/63	"	18 36			275 38
		144 40			
	10% O.H.	14 44	158 84		
	47'6" Transite Pipe @ .82		38 54		
	6 Hrs. Town Shovel @ 6.50		39 00		
	4 Hrs. Trucking @ 3.00		12 00		
	12 X 3 Patch		12 00		
	5 Yards Loam @ 3.00		15 00		
			275 38		

DATE _____

TOWN OF LEXINGTON — BOARD OF PUBLIC WORKS
SEWER DIVISION

Sketch of Service Here **12**

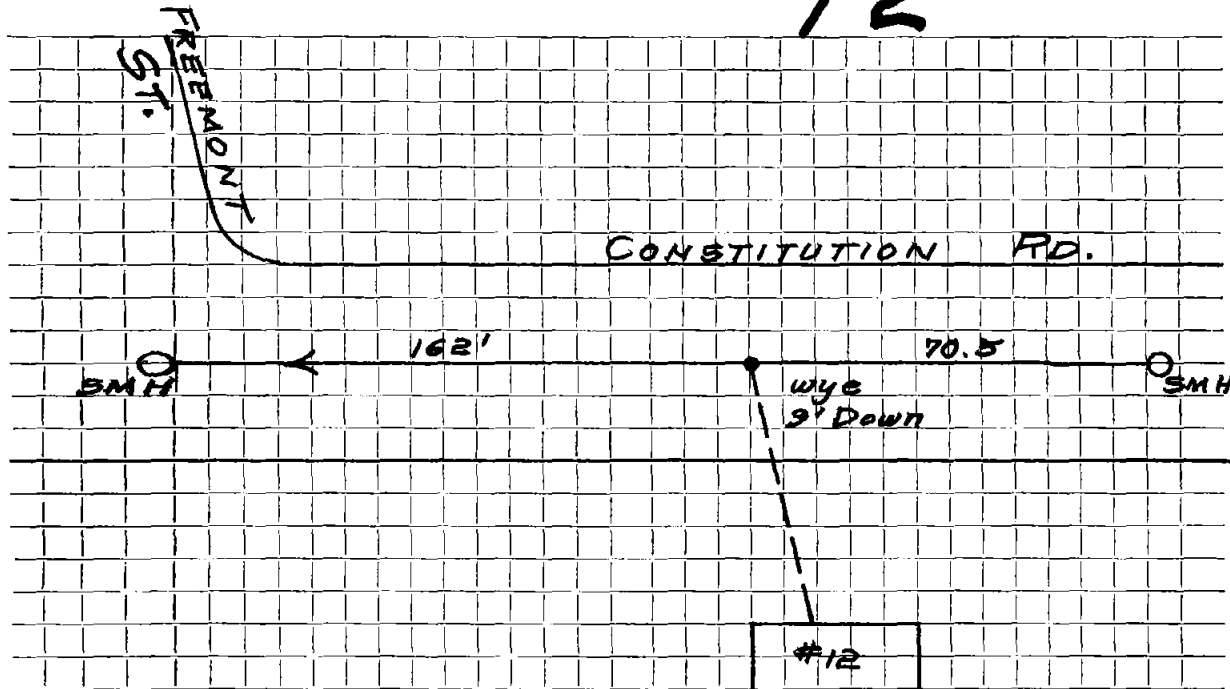

Connection made in Street. Work completed

Remarks:
.....
.....