

Name John Kang

Service No. 206

Address #15 Constitution Rd.

Location

Kind of Pipe

Size

Size of Main

~~Renewal~~ New Service

WC# 7748

Location

Comm 3-25-63

Date	Material	Amount	Total	Date		Amount
12-15-62	Labor	80.47		11-28-62	Deposit	300.00
12-17-62	"	140.71		6-3-63	Abate	178.00
12-18-62	"	84.85	306.03	6-10-63	Paid	200.62
	10% O.H.	30.60	336.63		NON CHARGE	678.62
72	6" Transite pipe @.82		59.04	12-15-62	Labor	40.22
35	3/4" Ton 3/4" Stone @1.50		53.62			
32	ton Gravel @.85		27.20			
2	11 ¹ / ₂ " Transite Bend @4.09		8.18			
1	22 ¹ / ₂ " Transite Bend		4.09			
1	6" Duplex Adapter		1.62		(Cont.)	
1	90° Transite Elbow		4.09	5	hrs. Loader @5.00	25.00
1	6 x 8 Service Saddle		5.65	1	hr. Trailer @3.00	3.00
8	x 4 Street Patch		8.00	7	hrs. Pumping @1.00	7.00
15	8 Driveway Patch		15.00		Spring Loam & Seed	20.00
9	hrs. Town Shovel @6.50		58.50			678.62
9	hrs. Trucking @3.00		27.00			
3	hrs. Compressor @5.00		15.00			


DATE _____

TOWN OF LEXINGTON — BOARD OF PUBLIC WORKS

SEWER DIVISION

Sketch of Service Here

15

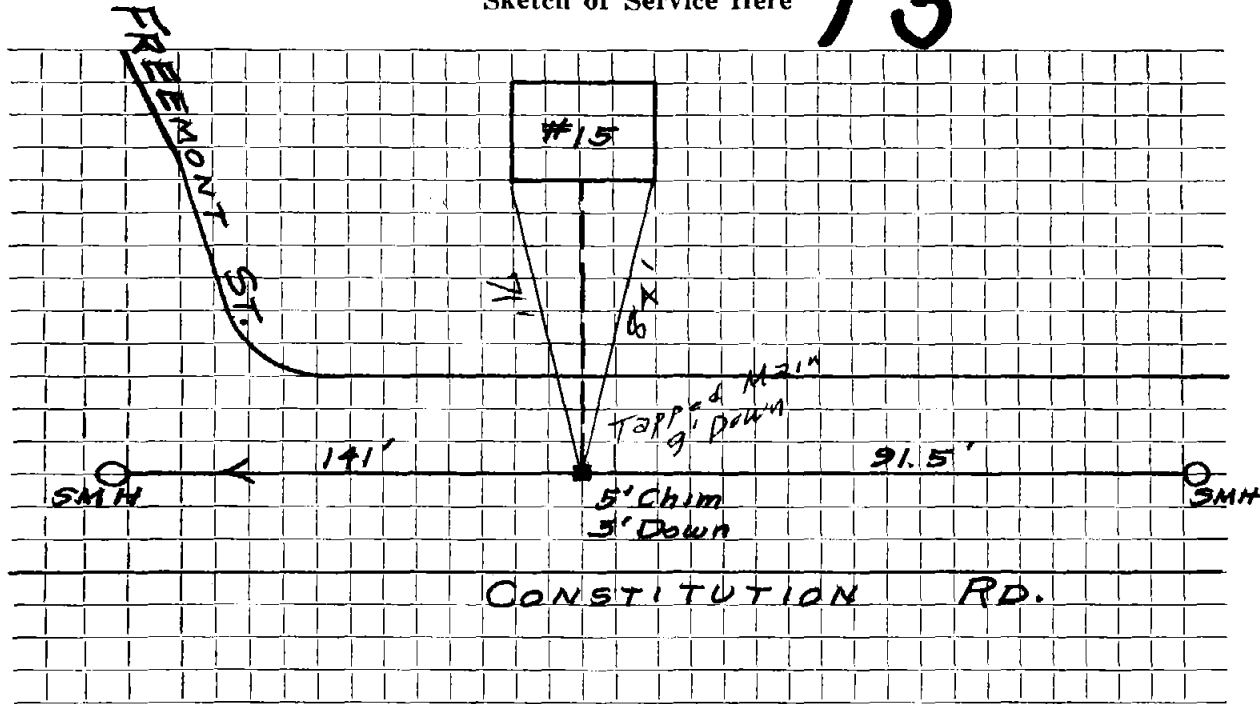

Connection made in Street. Work completed

Remarks:
.....
.....