

Name Richard I. Jones

Service No.

Address 18 Constitution Road

Lot 5

Location

Kind of Pipe Russell Sibley

Size

Size of Main

Repair—Renewal—New Service Permit #330

Location


Date	Material	Amount	Total	Date	Amount
6/11/65	73' 6" Transite pipe installed by contractor				

DATE _____

TOWN OF LEXINGTON — BOARD OF PUBLIC WORKS
SEWER DIVISION

Sketch of Service Here

18

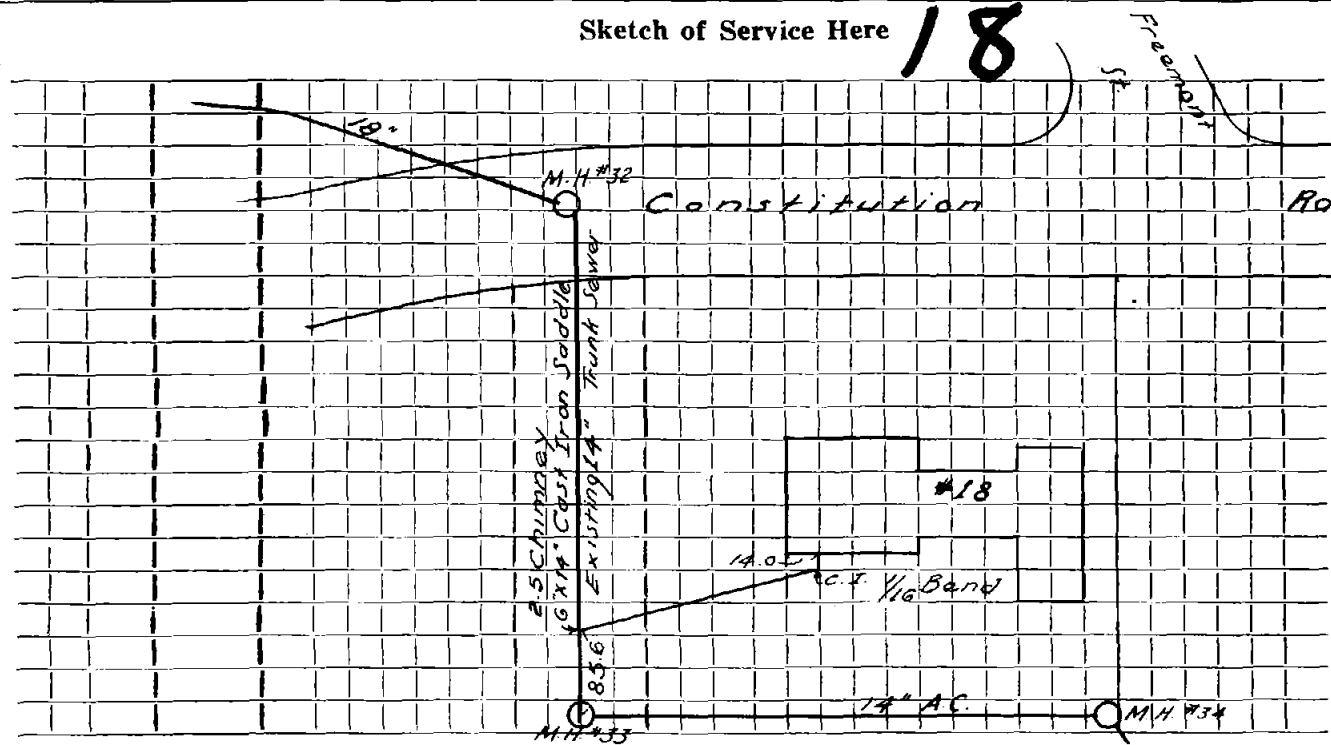

Connection made in Street. Work completed

Remarks:

.....