

Name John R. Raper

Service No. 149

Address # 2 Constitution Road

Location

Kind of Pipe

Size

Size of Main

Repair/Renewal—New Service

Location Conn 12-8-58

Date	Material	Amount	Total	Date	Amount
9/24/58	labor	20 00		9-2-58	150 00
9/25/58	"	51 66		12-8-58	11 27
		71 66	71 66		138 73
	10% overhead		7 17		
			78 83		
	37' 6" transite pipe @ .70		25 90		
	4 hrs. Pippin backhoe @ 4.50		18 00		
	2 hrs. town shovel @ 6.50		13 00		
	4 hrs. trucking @ .75		3 00		
			138 73		
	Labor				

TOWN OF LEXINGTON—DEPT. OF PUBLIC WORKS

SEWER DIVISION

DATE.....

NO.

The undersigned applies for the construction of a particular sewer connecting No.....
 Street and hereby agrees to comply with the Rules and Regulations governing the construction and use of Particular
 Sewers, as now or at any future time established by the Board of Selectmen.


Am't of estimate \$.....

Am't Paid \$.....

..... Owner

Sketch of Service Here **2**

Note - This S.S. is for #2 Constitution Rd.

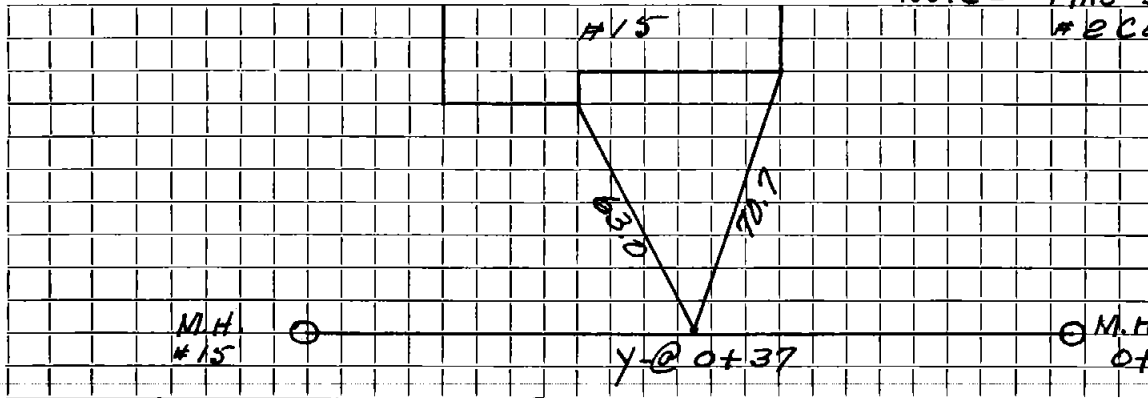

← Paul Revere Road →
 Street.

Work completed.....19..

Connection made in

Remarks: