

Name Leeland Const. Co.

Service No. 117

Address 22 Constitution Road

Location

Kind of Pipe

Size

Size of Main

~~Repair~~ ~~Renewal~~ — New Service


Location *Comm 5-22-60*

Date	Material	Amount	Total	Date	Amount
8-3-59	Labor	8 11		<i>7-7-60</i>	<i>Deposit</i> 150 00
	10% O. H.	81	8 92	<i>8-22-60</i>	<i>Retard</i> 38 66
	26' 6" Transite pipe @.70		18 20		111 34
	1 22 $\frac{1}{2}$ <sup>o</sup> Elbow		2 24		
	1 22 $\frac{1}{2}$ <sup>o</sup> Bend		6 21		
	1 Hr. Trucking @.75		75		
			36 32		
	BILL WHEN CONNECTED				
7-12-60	Labor	25 19			
	10% O.H.	2 52	27 71		
	45' 6" Transite pipe @78		35 10		
	1 22 $\frac{1}{2}$ <sup>o</sup> Transite Bend		6 21		
	2 Hrs Trucking @3.00		6 00		
			111 34		

DATE \_\_\_\_\_

**TOWN OF LEXINGTON — BOARD OF PUBLIC WORKS**  
**SEWER DIVISION**

Sketch of Service Here **22**

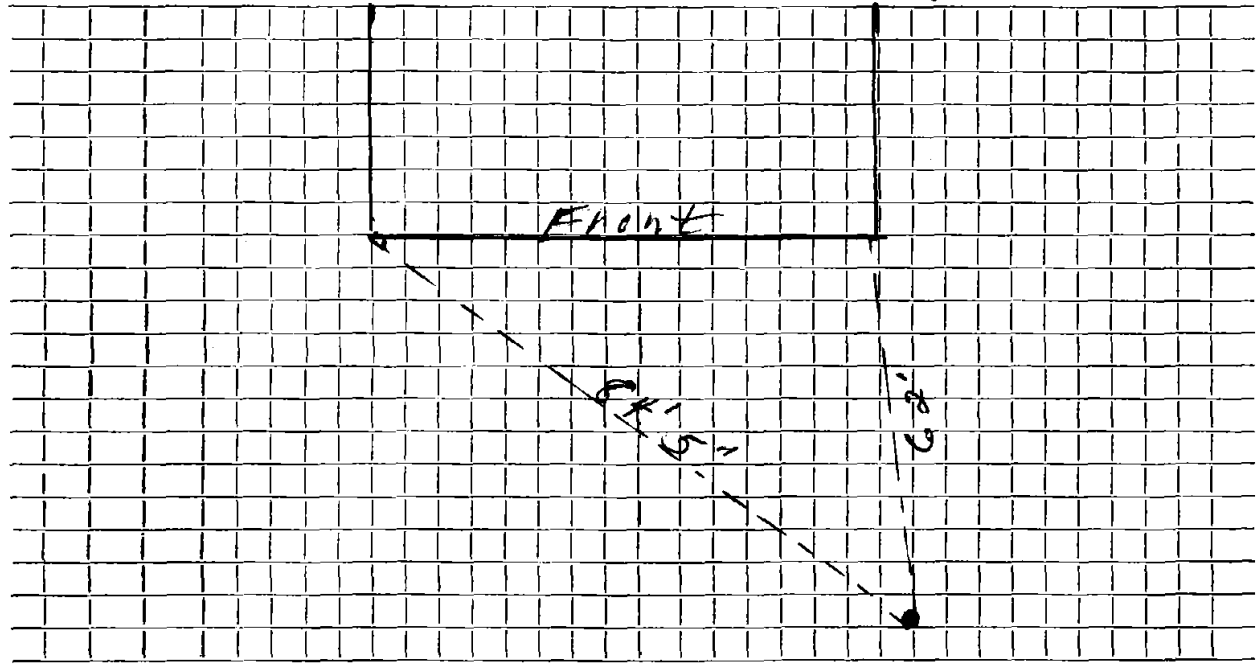

Connection made in ..... Street. Work completed .....

Remarks: .....  
.....  
.....