

Name Leeland Const. Co.

Service No. 118

Address 25 Constitution Road

Location

Kind of Pipe

Size

Size of Main

~~Repair~~ ~~Renewal~~ - New Service

Location


Comm 8-22-60

Date	Material	Amount	Total	Date	Amount
7-31-59	Labor	8 11		7-7-60	Deposit
	10% O. H.	81	8 92	8-5-60	Refund
	26' 6" Transite pipe @.70		18 20		
	1 11 $\frac{1}{4}$ ^o Bend		5 10		
	1 Hr. Trucking		75		
			32 97		
	BILL WHEN CONNECTED				
7-12-60	Labor	22 33			
	10% O.H.	2 23	24 56		
	58' 6" Transite pipe @.78		45 24		
	1 22 $\frac{1}{2}$ ^o Transite Elbow		2 24		
	1 11 $\frac{1}{4}$ ^o Transite Elbow		2 24		
	1 22 $\frac{1}{2}$ ^o Transite Bend		6 21		
			113 46		
				9-28-65	Plugged
				3/17/69	Tag

DATE _____

TOWN OF LEXINGTON — BOARD OF PUBLIC WORKS
SEWER DIVISION

Sketch of Service Here **25**

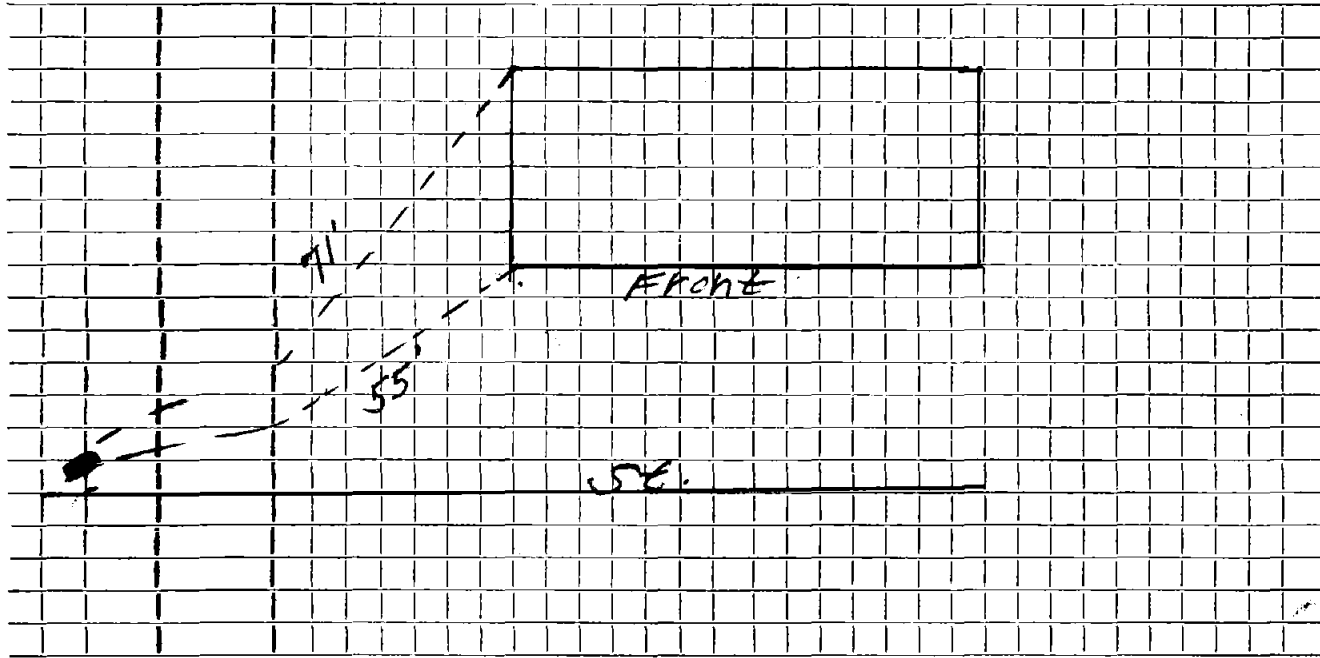

Connection made in Street. Work completed

Remarks:
.....
.....