

Name Leeland Construction

Service No. 199

Address 27 Constitution Road

Location

Kind of Pipe

Size

Size of Main

~~Repair~~ ~~Renewal~~ New Service

Location

Comm 11/21/60


Date	Material	Amount	Total	Date	Amount
7-31-59	Labor	8 11		10-4-60	150 80
	10% O. H.	81	8 92	12-13-60	19 06
	26' 6" Transite Pipe @.70		18 20		169 06
	1 11 1/4° Elbow		2 24		
	1 11 1/4° Bend		5 10		
	1 Hr. Trucking @.75		75		
			35 21		
	BILL WHEN CONNECTED				
10-10-60	Labor	19 68			
	10% O.H.	1 97	21 65		
	140' 6" Transite pipe @78		109 20		
	1 Hr. Trucking @3.00		3 00		
			169 06		

DATE \_\_\_\_\_

**TOWN OF LEXINGTON — BOARD OF PUBLIC WORKS**

**SEWER DIVISION**

Sketch of Service Here

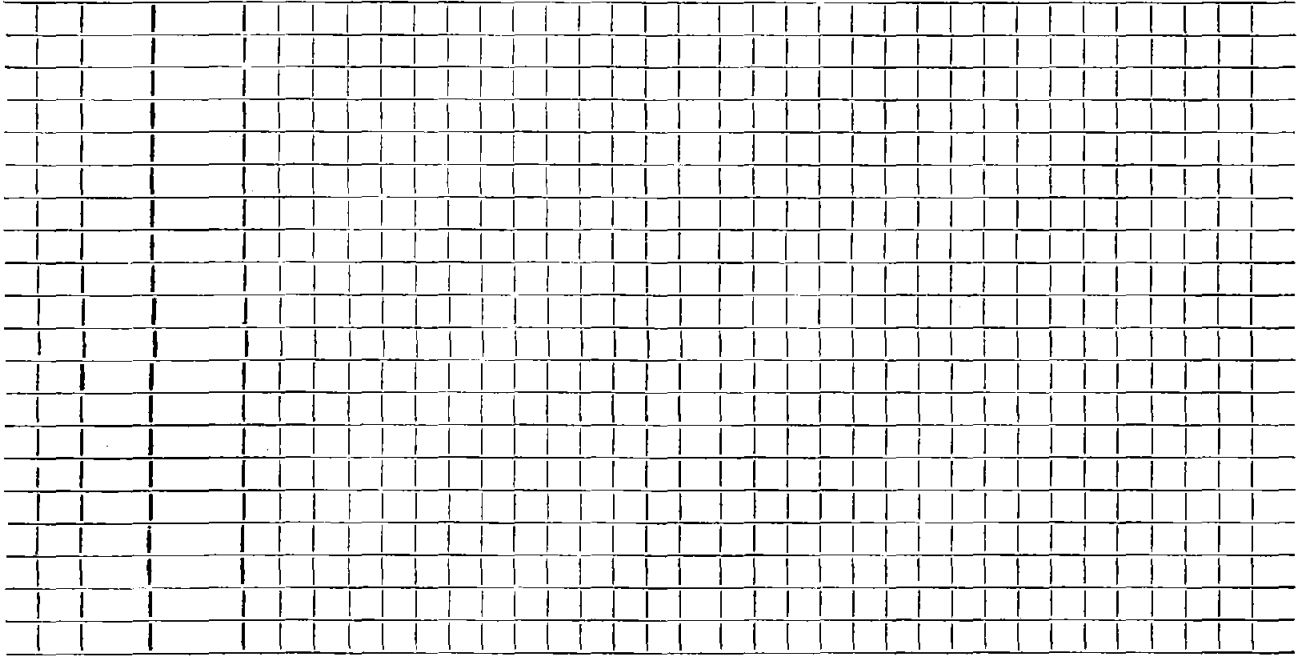

Connection made in ..... Street. Work completed .....

Remarks: .....  
.....  
.....