

Name Leeland Construction Co.

Service No. 168

Address 33 Constitution Road

Location

Kind of Pipe

Size

Size of Main

~~Repair~~ ~~Renewal~~ - New Service

Location

Comm 11-30-59

Date	Material	Amount	Total	Date		Amount
9-28-59				9-14-59	Deposit	150.00
11-3-59	Labor	51.15		11-30-59	Returned	46.35
	10% O.H.	5.12	56.27	9-26-75	Renewal	103.67
	47' 6" Transite Pipe @.70		32.90		8' 6" Transite	
	2 hrs. Town Shovel @6.50		13.00		1 6" X 2" Transite Nipple	
	2 hrs. Trucking @.75		1.50		1 6" - 1 1/4" Transite Elbow	
9-26-75	Renewal		103.67			
	12' 6" Transite					
				9-22-75	Roots 50' out	

DATE _____

TOWN OF LEXINGTON — BOARD OF PUBLIC WORKS

SEWER DIVISION

Sketch of Service Here

A large grid of graph paper, consisting of approximately 20 columns and 25 rows of small squares, intended for sketching service details.

Connection made in Street. Work completed

Remarks:
.....
.....



Name William F. Foley

Service No. 95

Address 33 Constitution Road

Location

Kind of Pipe

Size

Size of Main

~~Repair~~—Renewal—~~NEW SERVICE~~ W. O. #3746


Location NOV 24 1976

Date		Material	Amount	Total	Date		Amount
9/26/75	12'	6" Transite pipe @	1.56	18.72	9-23-75	Deposit	100.00
					11-24-75	Retained	
						NON CHARGE	18.72
					9/26/75	Labor	205.04
					9/29/75	"	40.38
						8' 6" Transite pipe @1.56	31.20
						1 2' x 6' transite nipple	5.39
						1 1 1/4" Elbow	3.84
						1 ton 3/4" Stone	1.50
						4 hrs. Town Shovel @6.50	26.00
						4 hrs. Trucking @3.00	12.00
						1 hr. Loader	4.00
							<u>329.35</u>

DATE _____

TOWN OF LEXINGTON — BOARD OF PUBLIC WORKS
SEWER DIVISION

Sketch of Service Here

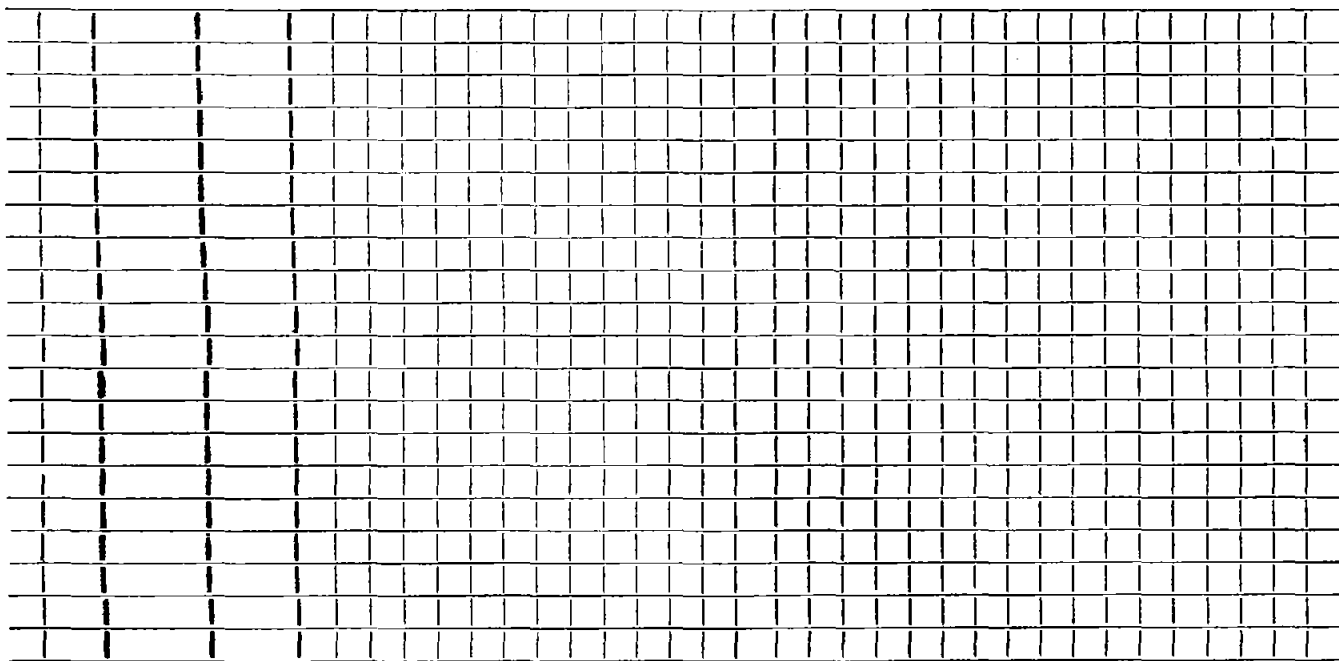

Connection made in Street. Work completed

Remarks:

.....

.....

.....