

Name Hartley Pond

Service No. 40

Address 4 Constitution Road

Location

Kind of Pipe

Size

Size of Main

~~Repair~~ ~~Renewal~~ ~~New Service~~

Location

Date	Material	Amount	Total	Date	Amount
5-6-58	Labor	135.18			
	10% O.H.	15.52	148.70	2-25-59	
	85' 6" Transite pipe @ .70		59.50		
	4' 6" Clay Pipe @ .435		1.74		
	1 22 $\frac{1}{2}$ <sup>o</sup> Transite bend		6.21		
	1 6" Clay Elbow		1.88		
	24 3/4 ton Bank Gravel		21.04		
	3 hrs. Town Shovel @ 6.50		19.50		
	4 hrs. Trucking @ .75		3.00		
	3 hrs. Pump @ 1.00		3.00		
			<u>264.57</u>		
	<b>Labor</b>				

*Deposit*  
*Paid*

200 00  
64 57  
264 57

# TOWN OF LEXINGTON—DEPT. OF PUBLIC WORKS

## SEWER DIVISION

DATE.....

NO.....


The undersigned applies for the construction of a particular sewer connecting No.....  
 Street and hereby agrees to comply with the Rules and Regulations governing the construction and use of Particular  
 Sewers, as now or at any future time established by the Board of Selectmen.

Am't of estimate \$.....

Am't Paid \$.....

..... Owner

Sketch of Service Here **4** S.S. For # 4  
 Constitution Rd.

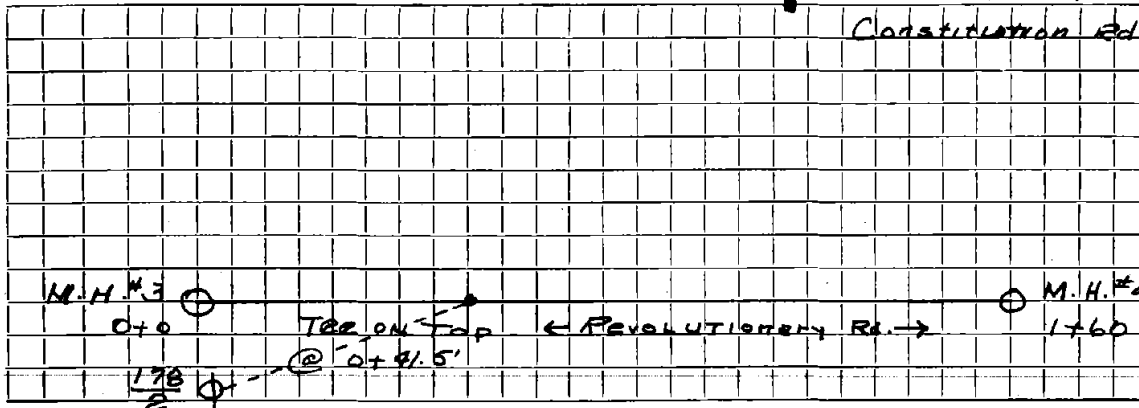

Connection made in..... Street.

Work completed.....19..

Remarks: