

Name **Martin Lichterman**

Service No. **13**

Address **5 Constitution Road**

Location *Common 8-4-58*

Kind of Pipe

Size

Size of Main

~~Repair~~ ~~Renewal~~ **New Service**

Location

XXXXXXXXXXXXXXXX

Date	Material	Amount	Total	Date		Amount
3-31-58	Labor	66.18		1-30-58	Deposit	250 00
	10% overhead	6.62	72.80	8-4-58	Retuned	95 91
	40' 6" Transite pipe @.70		28.00			154 09
	3 11 $\frac{1}{4}$ " Transite Bends @ 5.80		17.40			
	1 Long 45° Bend		7.60			
	1 6" Transite Elbow 90°		5.29			
	3 hrs. Town Shovel @ 6.50		19.50			
	2 hrs. Trucking @.75		1.50			
	2 hrs. Pump @ 1.00		2.00			
			<u>154.09</u>			
	Labor					

TOWN OF LEXINGTON—DEPT. OF PUBLIC WORKS
SEWER DIVISION

DATE.....

NO.

The undersigned applies for the construction of a particular sewer connecting No.....
 Street and hereby agrees to comply with the Rules and Regulations governing the construction and use of Particular
 Sewer, as now or at any future time established by the Board of Selectmen.


Am't of estimate \$.....

Am't Paid \$.....

..... Owner

Sketch of Service Here **5**

S.S. For House # 5

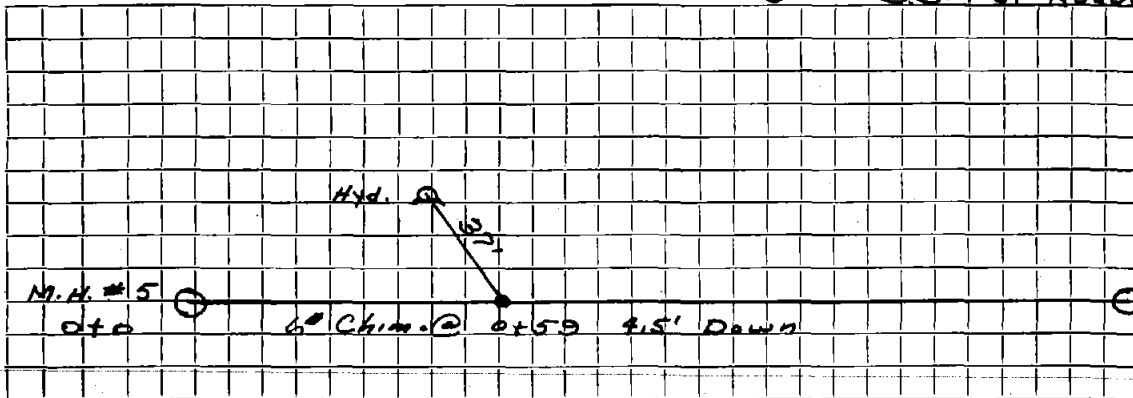

Connection made in..... Street.

Work completed.....19..

Remarks:

Name

Service No.

Address 5 CONSTITUTION Road

Location

Kind of Pipe

Size

Size of Main

Repair—Renewal—New Service

Location

Date

Material

Amount

Total

Date

Amount

3-31-58

40' 6" Transite

3 6"-1 1/4° Transite Bends

1 6"-45° Bend (Long) Transite

1 6"-90° Transite Elbow

Labor

