

Name Carlo L. Pommer

Service No. 170

Address 7 Constitution Road

Location

Kind of Pipe

Size

Size of Main

~~Repair~~ ~~Renewal~~ ~~XXXXXXXX~~ ~~XXXXXXXX~~ New Service

Location

Comm 12-18-61

Date	Material	Amount	Total	Date	Amount	
	20' 6" Transite pipe @ 3.50			11-14-61	Deposit	300 00
	installed by cont.		70 00	1-2-62	Paid	29 57
11/20/61	Labor	112 59		11-14-61		379 57
11/21/61	"	53 48			20' 6" Transite	
11/22/61	"	51 16				
		217 23				
	10% O.H.	21 72	238 95			
	35' 6" Transite Pipe @ .78		27 30			
	2 1 1/4" Transite Bends @ 5.10		10 20			
	1 6" Duplex Adapter		1 62			
	3 Hrs. Town Shovel @ 6.50		19 50			
	4 Hrs. Trucking @ 3.00		12 00			
	Labor Previous Charge		70 00			
			379 57			

TOWN OF LEXINGTON—DEPT. OF PUBLIC WORKS

SEWER DIVISION

DATE.....


NO.....

The undersigned applies for the construction of a particular sewer connecting No..... Street and hereby agrees to comply with the Rules and Regulations governing the construction and use of Particular Sewer, as now or at any future time established by the Board of Selectmen.

Am't of estimate \$.....

Am't Paid \$.....

..... Owner

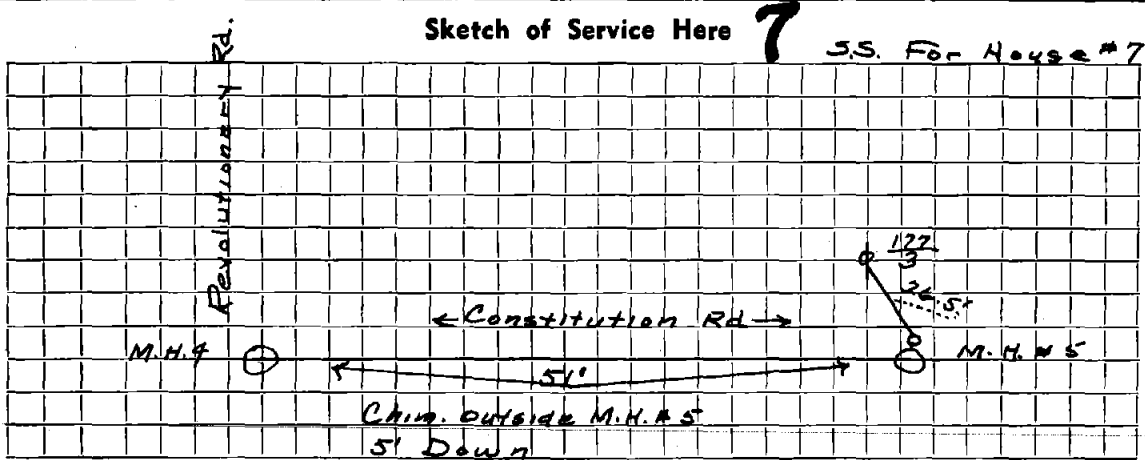

Connection made in..... Street.

Work completed.....19..

Remarks:

