

Name. Arthur Morse

Service No. 75

Address # 8 Constitution Rd.

Location

Kind of Pipe

Size

Size of Main

Repair—Renewal—New Service

WO# 8038

Location Comm 10-28-63


| Date | Material | Amount | Total | Date | Amount |
|---------|---------------------------|--------|---------------|----------|--------|
| 6-25-63 | Labor | 75 04 | | 6-21-63 | 250 00 |
| 6-27-63 | " | 26 48 | | 10-28-63 | 31 02 |
| | 10% O.H. | 10 15 | 111 67 | | 218 98 |
| | 46' 6" Transite Pipe @.82 | | 37 72 | | |
| | 1 90° Transite Elbow | | 4 09 | | |
| | 3 hrs. Town Shovel @ 6.50 | | 19 50 | | |
| | 3 hrs. Trucking @ 3.00 | | 9 00 | | |
| | 1 hr. Trailer @ 3.00 | | 3 00 | | |
| | 16 x 3 Patch | | 16 00 | | |
| | 6 yds. loam @3.00 | | 18 00 | | |
| | | | <u>218 98</u> | | |

DATE _____

TOWN OF LEXINGTON — BOARD OF PUBLIC WORKS

SEWER DIVISION

Sketch of Service Here **8**

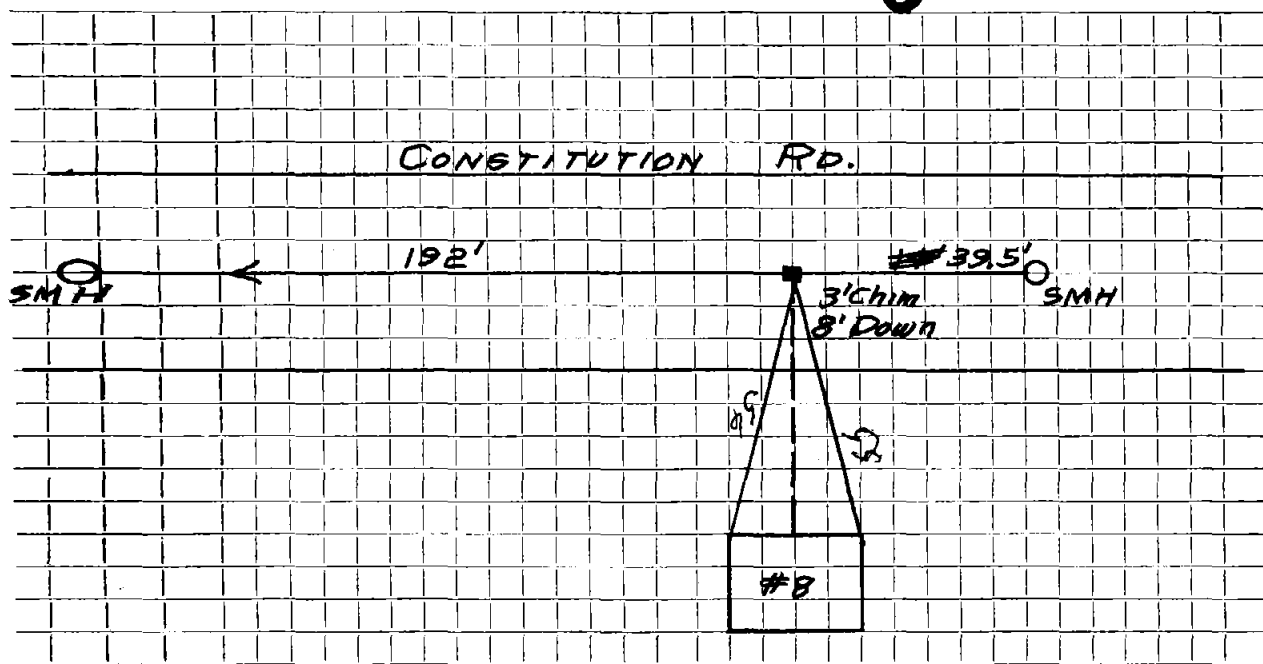

Connection made in Street. Work completed

Remarks:
.....
.....