


DATE 1/2/19

TOWN OF LEXINGTON — BOARD OF PUBLIC WORKS
SEWER DIVISION

Sketch of Service Here

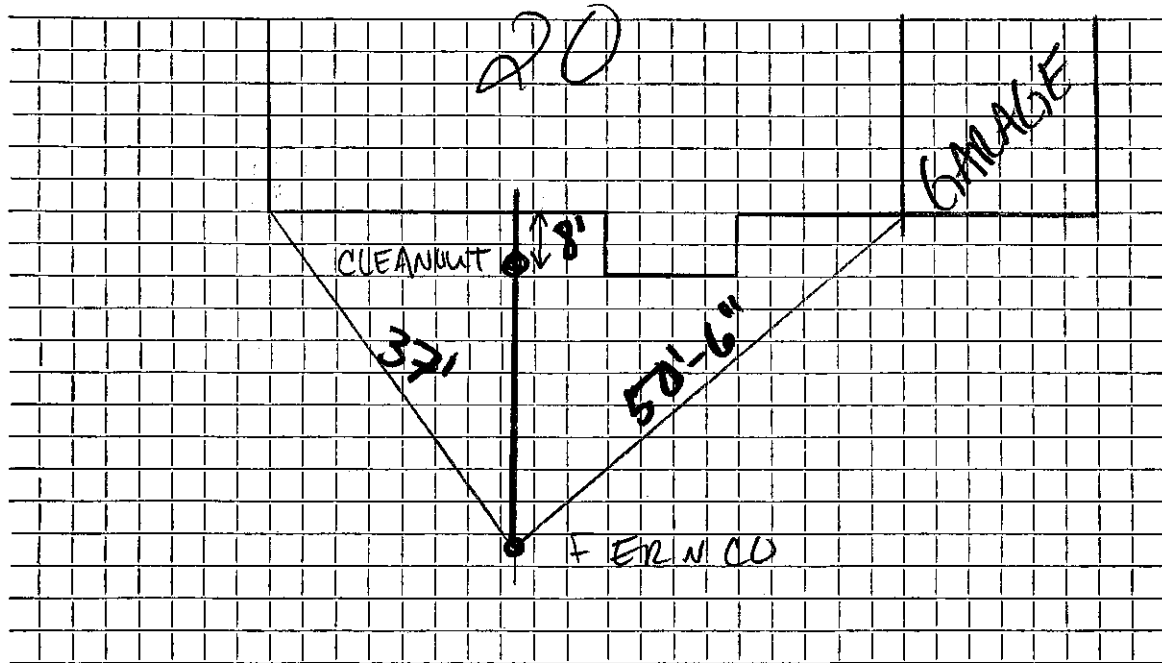

Connection made in COOKE ROAD Street. Work completed

Remarks: