

Name Marilyn B. Cicero

Service No. 114

Address 11 Cooke Road

Location Lot 16A

Kind of Pipe

Size

Size of Main

Repair—Renewal—New Service Valeri #1763

Location DEC 31 1970


Date		Material	Amount	Total	Date	Amount
<del>Nov/1970</del>	<del>16</del>	<del>6" Transite pipe @ 7.50</del>		<del>\$120.00</del>	<del>11-30-70</del>	<del>120.00</del>
11/3/70	57'	6" Transite pipe				
	5'	4" Cast Iron pipe			11- - 70	
					16' 6" Transite	

DATE \_\_\_\_\_

TOWN OF LEXINGTON — BOARD OF PUBLIC WORKS  
SEWER DIVISION

Sketch of Service Here

11

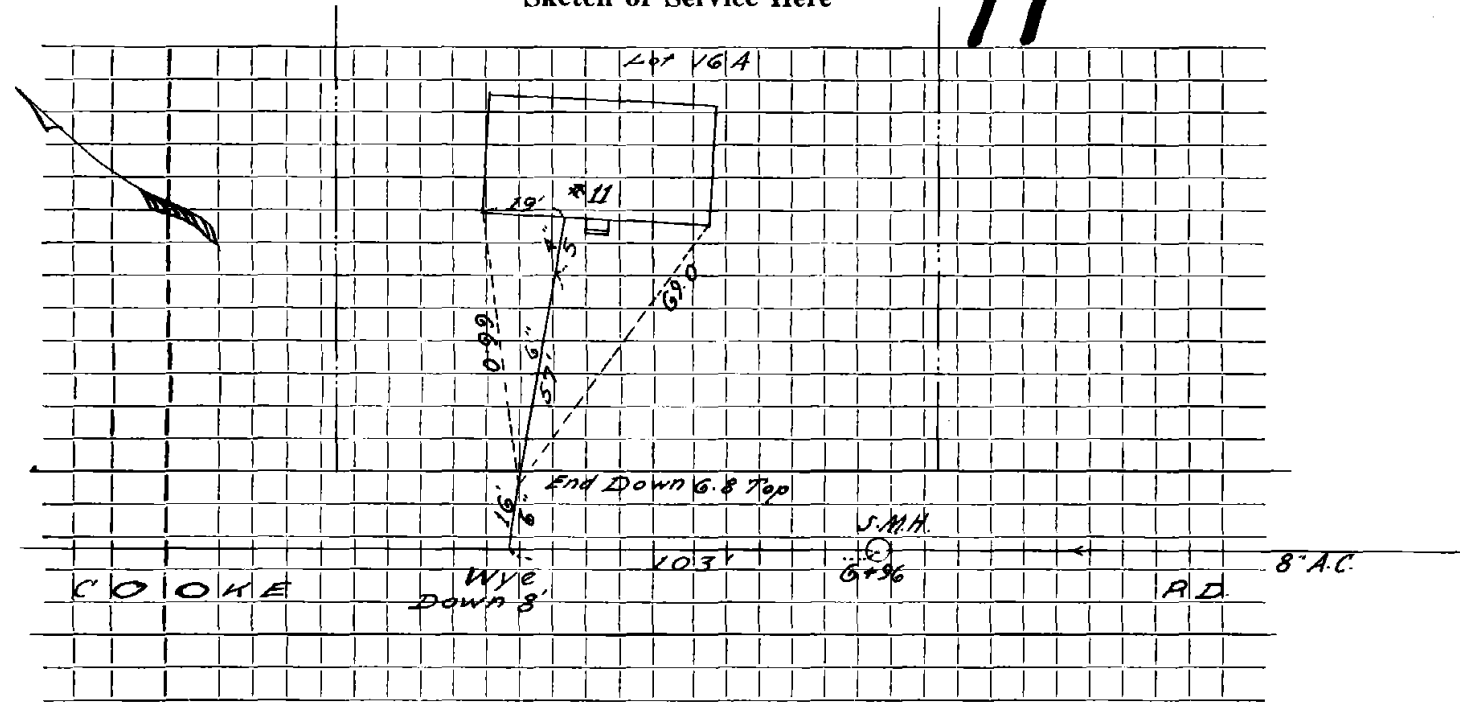

Connection made in ..... Street. Work completed .....

Remarks: .....  
.....  
.....