

Name Kenneth Heyda

Service No. 8

Address 14 Cooke Road

Location Lot 10

Kind of Pipe

Size

Size of Main

Repair—Renewal—New Service Valeri #1814


Location APR 21 1971

Date	Material	Amount	Total	Date		Amount
Nov/1970	18' - 6" Transite pipe @	7.50	\$135.00	3-23-71	Deposit	135.00
3/25/71	28' 6" Transite pipe					
	17' 4" Cast Iron pipe			11- - 70		
					18' 6" Transite	

DATE _____

TOWN OF LEXINGTON — BOARD OF PUBLIC WORKS
SEWER DIVISION

Sketch of Service Here **14**

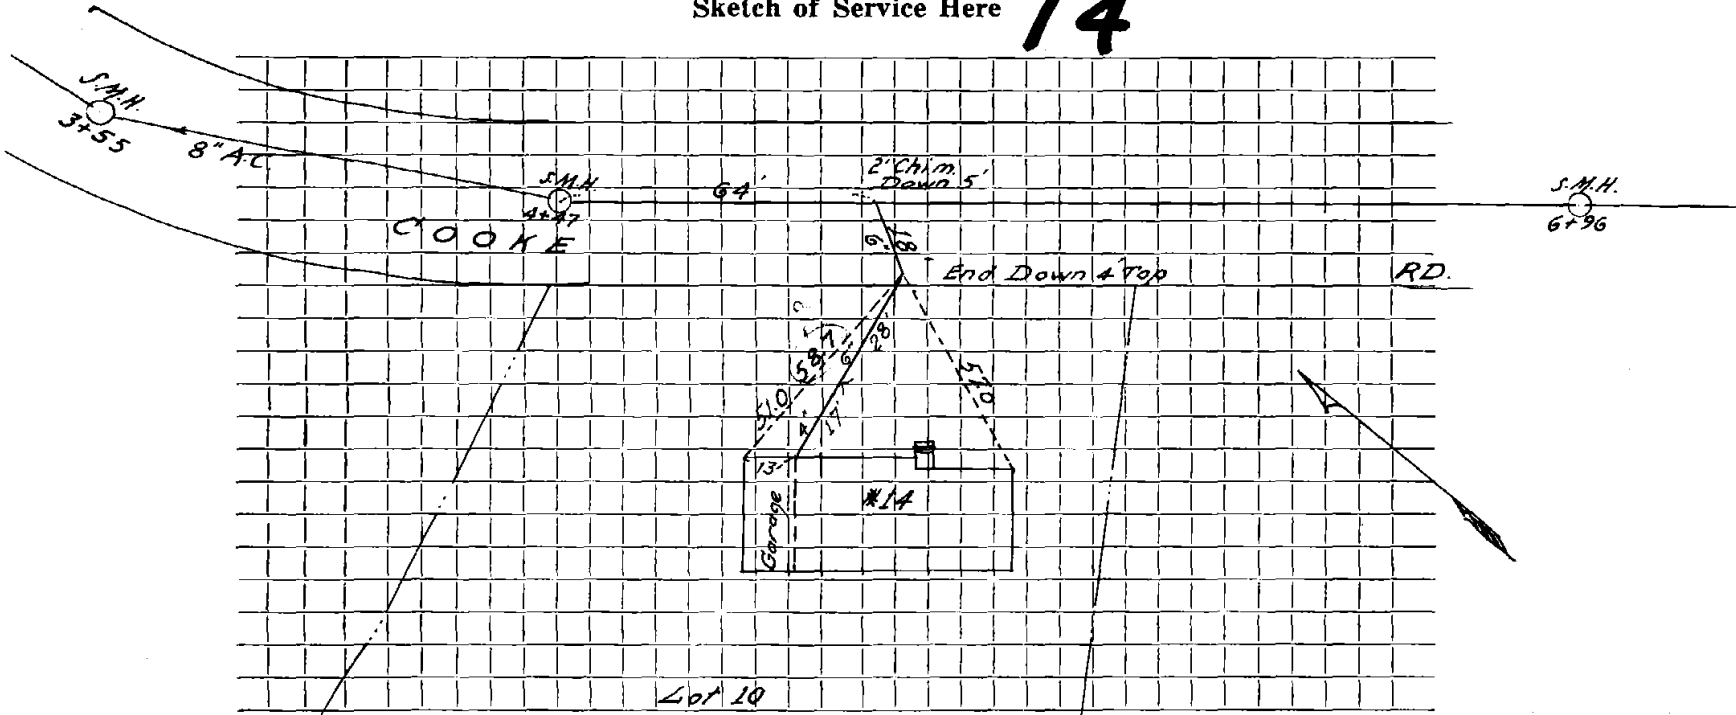

Connection made in Street. Work completed

Remarks:
.....
.....