

Name *Subhash Malhotra*

Service No. 30

Address 16 Cooke Road

Location *Lot 11*

Kind of Pipe

Size

Size of Main

~~Repair/Renewal~~ **New Service** *Baptiste #3888*

Location

**SEP 17 1984**

Date	Material	Amount	Total	Date	Amount
------	----------	--------	-------	------	--------

<del>Nov/1970</del> 21'	<del>6" Transite pipe @</del>	7.50	\$157.50	<del>8-11-84</del>	<i>Deposit</i>	157.50
-------------------------	-------------------------------	------	----------	--------------------	----------------	--------

8/21/84	42'	6" PVC				
---------	-----	--------	--	--	--	--

	7½'	4" Cast		11- - 70		
--	-----	---------	--	----------	--	--


		4" x 6" Donut		21' 6" Transite		
--	--	---------------	--	-----------------	--	--

		AC to PVC Adpt.				
--	--	-----------------	--	--	--	--

DATE \_\_\_\_\_

TOWN OF LEXINGTON — BOARD OF PUBLIC WORKS

SEWER DIVISION

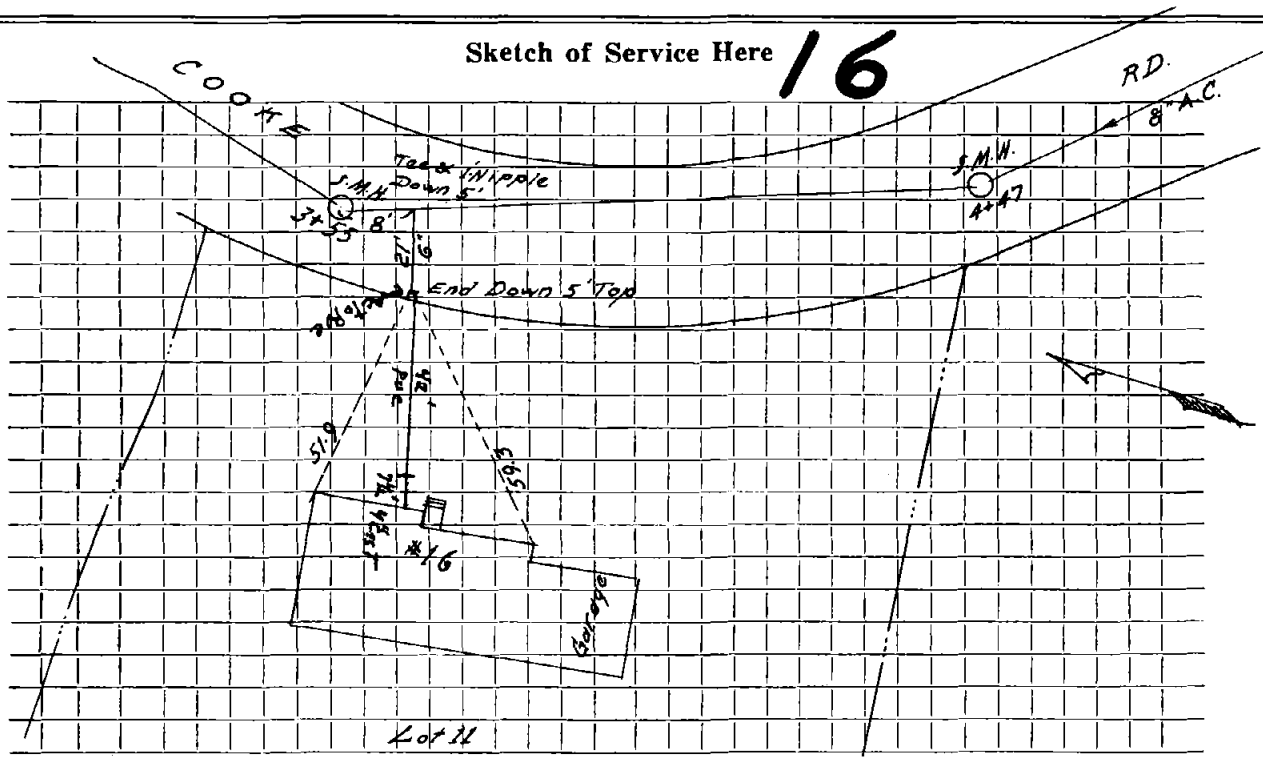

Connection made in ..... Street. Work completed .....

Remarks: .....

.....

.....