

Name Paul Hamburger

Service No. 2

Address 18 Cooke Road

Location Lot 18

Kind of Pipe

Size

Size of Main

Repair—Renewal—New Service Valeri #1807


Location APR 21 1971

Date		Material	Amount	Total	Date		Amount
Nov/1970	19'	<del>6" Transite pipe @</del>	7.50	\$142.50	3-2-71	Deposit	142.50
3/18/71	43'	6" Transite pipe					
	8'	4" Cast Iron pipe			11- - 70		
					19'	6" Transite	

DATE \_\_\_\_\_

TOWN OF LEXINGTON — BOARD OF PUBLIC WORKS  
SEWER DIVISION

Sketch of Service Here **18**

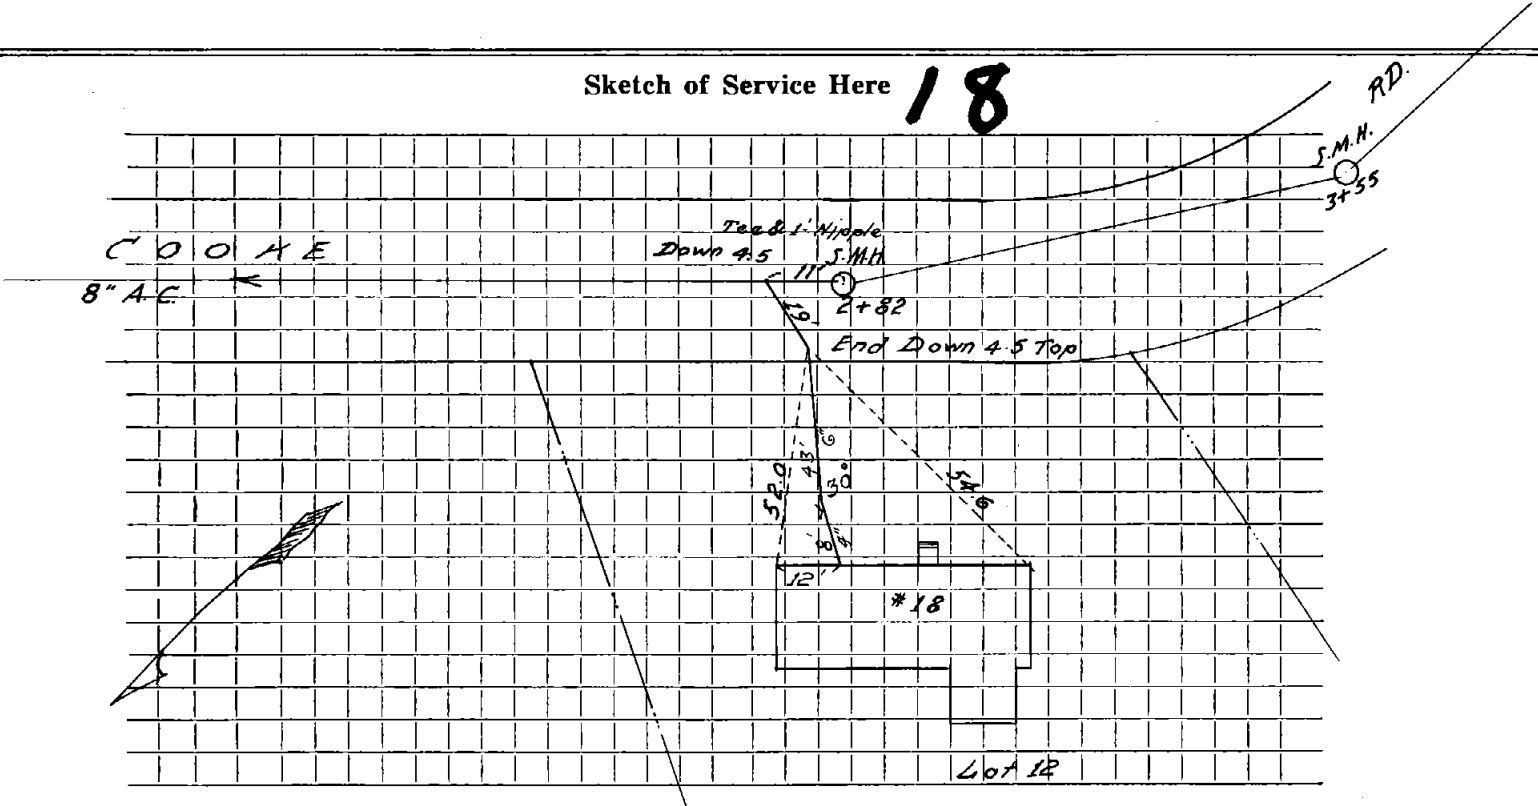

Connection made in ..... Street. Work completed .....

Remarks: .....  
.....  
.....