

Name William R. MacDonald

Service No. 126

Address 3 Cooke Road

Location Lot 30

Kind of Pipe

Size

Size of Main

Repair—Renewal—New Service Ferrari #1795

Location APR 21 1971


Date	Material	Amount	Total	Date	Amount
Oct/70	24'	6" Transite pipe @7.50		11-9-70	Deposit
11/24/70	47'	6" Transite Pipe	\$180.00		180.00
	10'	4" Cast Iron Pipe		10 - 70	
				24' 6" Transite	

DATE _____

TOWN OF LEXINGTON — BOARD OF PUBLIC WORKS
SEWER DIVISION

Sketch of Service Here

3

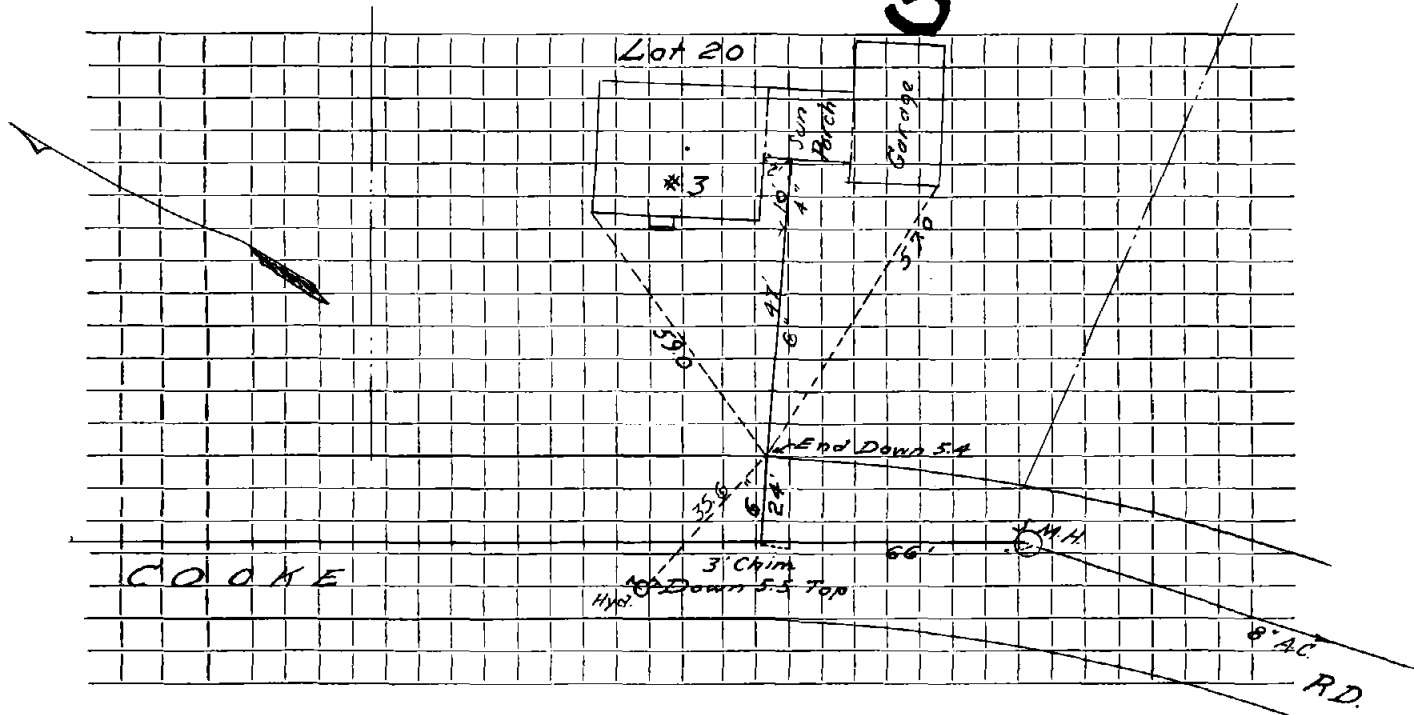

Connection made in Street. Work completed

Remarks:

.....