

Name Rosalind Wasserman

Service No. 5

Address 5 Cooke Road

Location Lot 19

Kind of Pipe

Size

Size of Main

Repair—Renewal—New Service Valeri #2391

Location AUG 16 1976


Date		Material		Amount	Total	Date	Amount	
Nov/1970		6" Transite pipe @ 7.50			165.00	3/15/74	Deposit	165 00
4/12/74	40'	6" Transite Pipe						
	5'	4" Cast Iron Pipe				11 - - 70		
						22' 6" Transite		

DATE _____

TOWN OF LEXINGTON — BOARD OF PUBLIC WORKS

SEWER DIVISION

Sketch of Service Here **5**

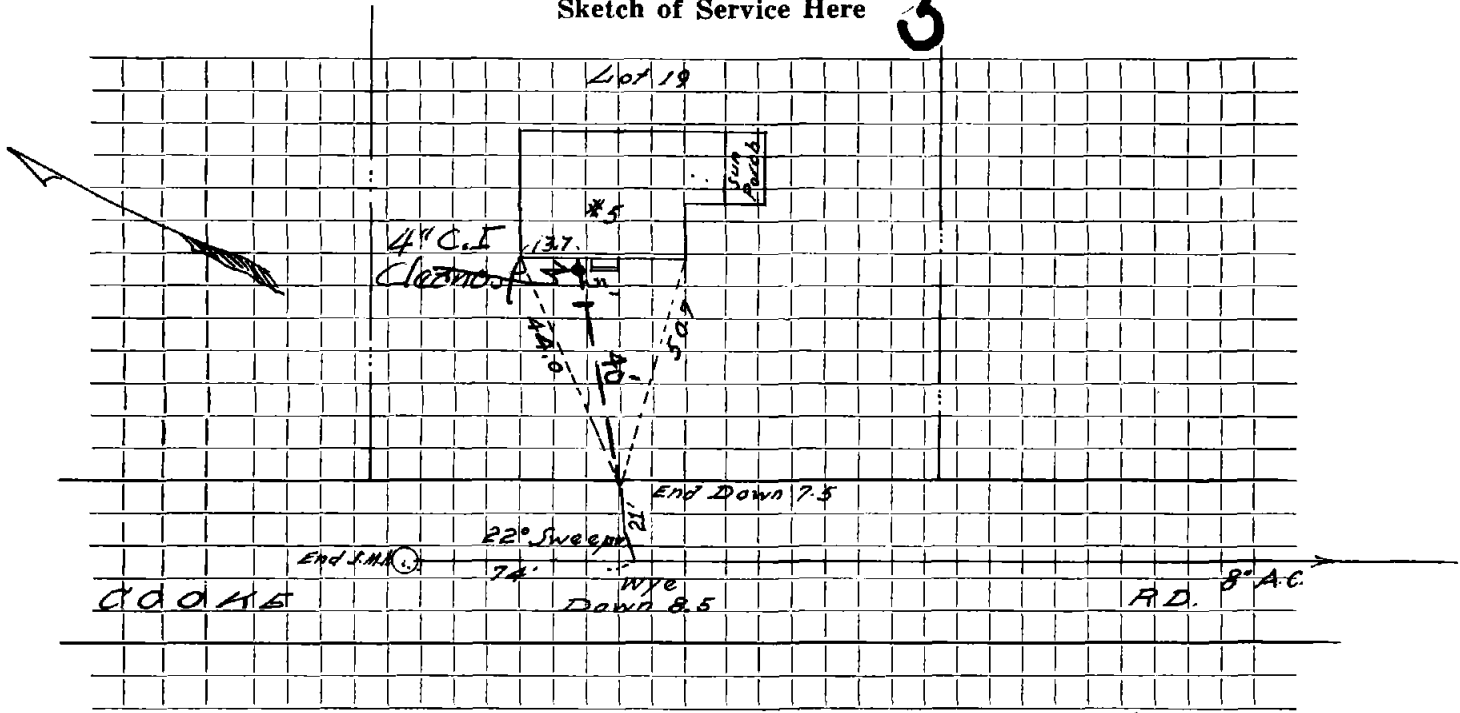

Connection made in ~~11.5' of~~ 500K Rd. Street. Work completed 4/12/24

Remarks:

.....

.....