


DATE 02/08/24

TOWN OF LEXINGTON — BOARD OF PUBLIC WORKS

SEWER DIVISION

Sketch of Service Here

↳ COOKE RD

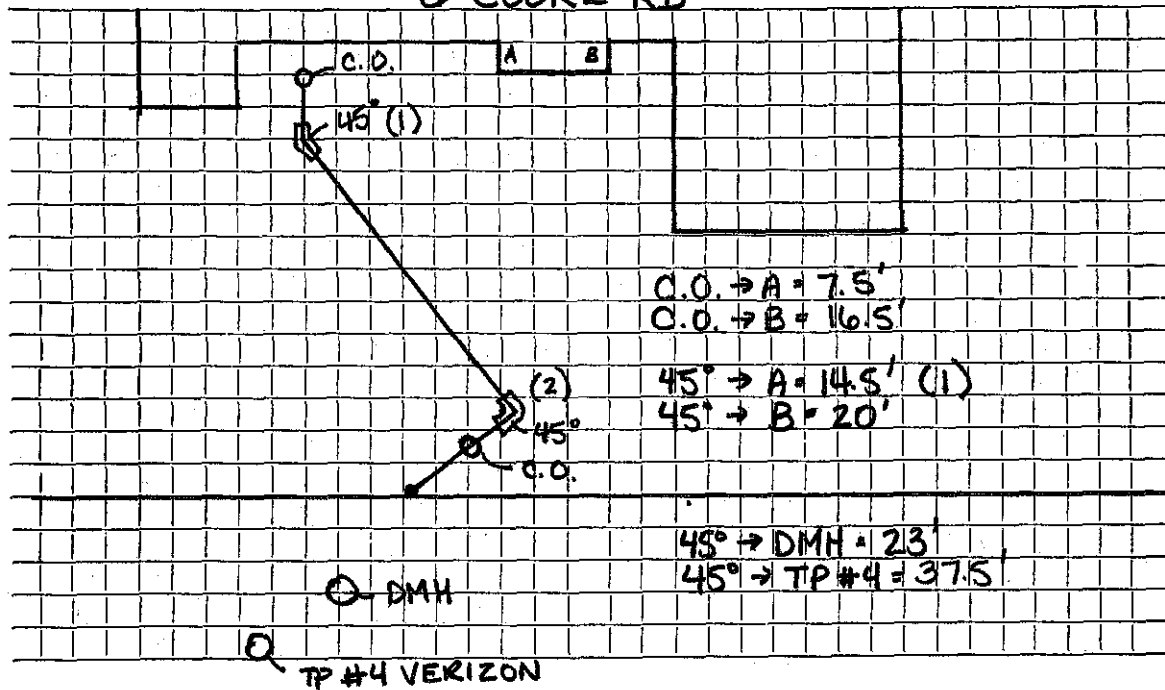

Connection made in Street. Work completed

Remarks: Installed by Sadco

