


DATE _____

TOWN OF LEXINGTON — BOARD OF PUBLIC WORKS SEWER DIVISION

Sketch of Service Here

9

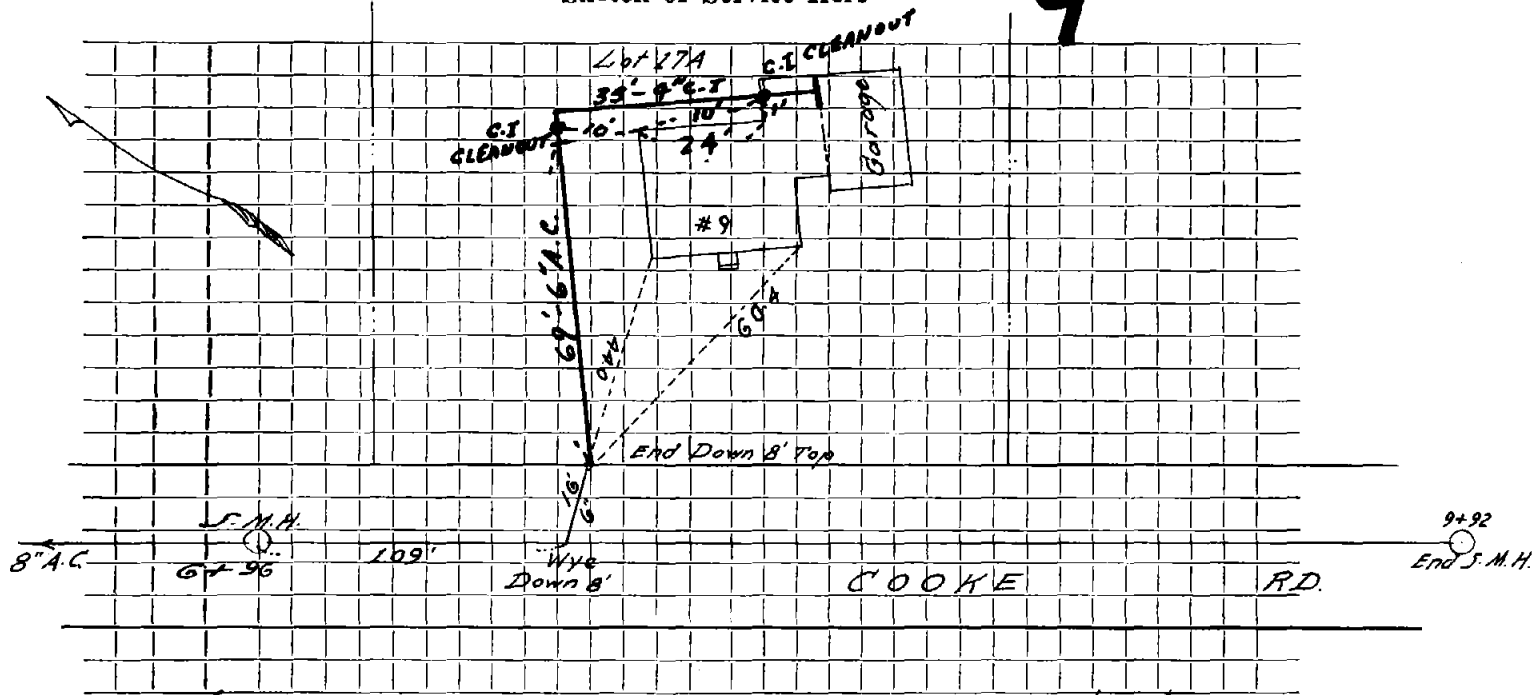

Connection made in 919 Cooke Rd. Street.

Work completed 2/13/76

Remarks: