

Name Robert Brown

Service No. 26 1040

Address 27 Coolidge Avenue

Lexington, Mass.

Location 27 Coolidge Avenue

Kind of Pipe

Size

Size of Main

~~Repair/Renewal~~ New Service

Location

Date	Material	Amount	Total	Date		Amount
Oct. 22, '46	Labor	29 48		Oct 18 '46	Deposited	36 00
23	"	27 02	56 50	Jan 8 '47	Card	42 09
	10% Overhead		5 65			77 09
	46' - 6" Sewer Pipe @ .234		10 76			
	1 - 6" Bend		67			
	Joint Compound		2 76			
	Trucking 1 hr. @ .75		75			
			77 09			
	Labor			3-6-46	Roots	
				7-29-82	" 30' - 40' 14T	

TOWN OF LEXINGTON—DEPT. OF PUBLIC WORKS
SEWER DIVISION

DATE


NO.

The undersigned applies for the construction of a particular sewer connecting No.
Street and hereby agrees to comply with the Rules and Regulations governing the construction and use of Particular
Sewers, as now or at any future time established by the Board of Selectmen.

Am't of estimate \$.

Am't Paid \$.

..... Owner

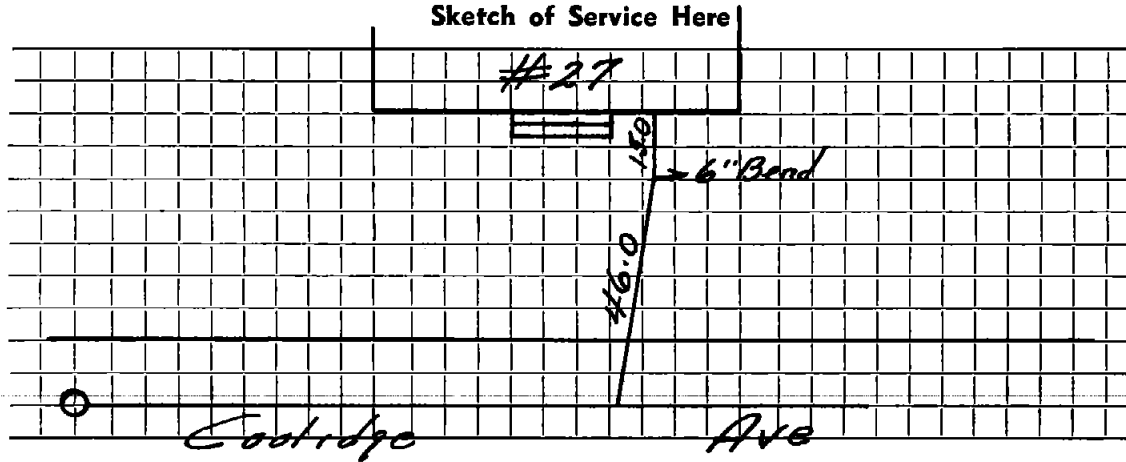

Connection made in Street.

Work completed 19..

Remarks: